

STONE
K4
5-27-70

MISSISSIPPI
BOARD OF WATER COMMISSIONERS
416 North State Street
Jackson, Mississippi 39201

CODED

WATER WELL DRILLERS LOG

5-27 1970 Parwell Anderson ~~Anderson~~ STONE
date well completed firm name county well located

LANDOWNER: James W. Willis	description of formations encountered	from	to
McHenry	TOP SOIL	0	3
(mailing address)	Red Clay	3	30
WELL LOCATION:	FINE SAND	20	25
sec. 9 T. 4 S. R. 12 W.	White Clay	25	40
5 miles W of McHenry	Blue Clay	40	151
(distance) (direction) (nearest town)	FINE SAND	151	160
WELL PURPOSE: HOME	COARSE SAND	160	170
(home, irrigation, municipal, industrial)			
WELL COMPLETION DATA:			
(1) diameter (inches) 2"			
(2) total depth (feet) 170			
(3) static water level (feet) 40 below top of ground.			
(4) casing PLASTIC, 164 (material) (depth)			
(size) if telescope see back.			
(5) screen 6, 164 (length) (depth to top)			
2" PLASTIC (size) (material)			
(6) pump 1, 10 (HP) (yield gpm)			
ELECT (type power)			
(7) electric log (yes or no)			
(organization running log)			
(8) how well bottom plugged			
Back Wash Valve			
DRILLERS REMARKS:			


CODED

NOV 11 1971

MISS. Bd OF WATER COMM.

If well telescopes please sketch and show depths.

GROUND LEVEL

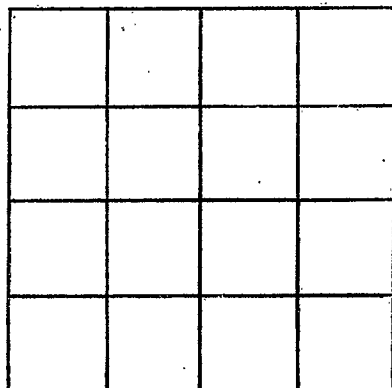

SECTION _____

Please indicate well location X.

ADDITIONAL INFORMATION

If more than one screen, show locations of each on sketch.