

STONE
K5
10-10-70

MISSISSIPPI
BOARD OF WATER COMMISSIONERS
416 North State Street
Jackson, Mississippi 39201

CODED

WATER WELL DRILLERS LOG

10-10 1970 Parnell Anderson STONE
date well completed firm name county well located

LANDOWNER: <u>Charles Garner</u>	description of formations encountered	from	to
<u>McHenry</u>	<u>TOP Soil</u>	<u>0</u>	<u>3</u>
	<u>Red Clay</u>	<u>3</u>	<u>21</u>
(mailing address)	<u>Coarse Sand</u>	<u>21</u>	<u>36</u>
WELL LOCATION:			
sec <u>20</u> T <u>4</u> S R <u>12</u> W of <u>McHenry</u> (distance) miles (direction) (nearest town)			
WELL PURPOSE: <u>Home</u> (home, irrigation, municipal, industrial)			
WELL COMPLETION DATA:			
(1) diameter (inches) <u>2</u>			
(2) total depth (feet) <u>36</u>			
(3) static water level (feet) <u>20</u> below above top of ground.			
(4) casing <u>Plastic</u> <u>30</u> (material) (depth)			
(size) If telescope see back.			
(5) screen <u>6</u> <u>30</u> (length) (depth to top)			
<u>2"</u> <u>Plastic</u> (size) (material)			
(6) pump <u>1</u> <u>12</u> (HP) (yield gpm)			
(type power)			
(7) electric log _____ (yes or no)			
(organization running log)			
(8) how well bottom plugged <u>Backwash Valve</u>			
DRILLERS REMARKS:			


CODED

JUN 11 1971

MISSISSIPPI BOARD OF WATER COMMISSIONERS

If well telescopes please sketch and show depths.

GROUND LEVEL

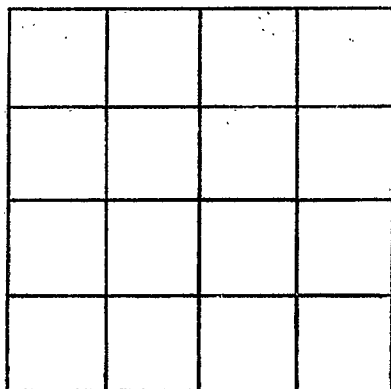

SECTION _____

Please indicate well location X.

ADDITIONAL INFORMATION

If more than one screen,
show locations of each on sketch.