

MISSISSIPPI
BOARD OF WATER COMMISSIONERS
416 North State Street
Jackson, Mississippi 39201

CODED

WATER WELL DRILLERS LOG

STONE
K 6
10-12-70

10-12 1970 Parvell Anderson Stone
date well completed firm name county well located

LANDOWNER: R.A. Goyner
Mc Henry
(mailing address)

description of formations encountered	from	to
<u>Top Soil</u>	<u>0</u>	<u>2</u>
<u>Red clay</u>	<u>2</u>	<u>15</u>
<u>Fine sand</u>	<u>15</u>	<u>22</u>
<u>White Clay</u>	<u>22</u>	<u>36</u>
<u>Blue Clay</u>	<u>36</u>	<u>89</u>
<u>Coarse Sand</u>	<u>89</u>	<u>106</u>

WELL LOCATION:
sec. 9 T. 4 R. 12 34
S W
4 miles W of Mc Henry
(distance) (direction) (nearest town)

WELL PURPOSE:
(home, irrigation, municipal, industrial)

- WELL COMPLETION DATA:
- (1) diameter (inches) 2
 - (2) total depth (feet) 106
 - (3) static water level (feet) 28 below top of ground.
 - (4) casing Plastic 100
(material) (depth)
(size) if telescope see back.
 - (5) screen 6 100
(length) (depth to top)
2 Plastic
(size) (material)
 - (6) pump 1/2 7
(HP) (yield gpm)
(type power)
 - (7) electric log _____
(yes or no)
(organization running log)
 - (8) how well bottom plugged
Bottom Plug Valve

CODED


JUN 11 1971

DRILLERS REMARKS:

MISS. Bd. OF
WATER COMM.

If well telescopes please sketch and show depths.

GROUND LEVEL

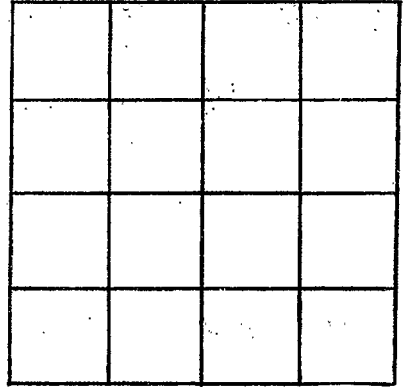

SECTION _____

Please indicate well location X.

ADDITIONAL INFORMATION

If more than one screen, show locations of each on sketch.