

STONE  
K 7 CODED  
8-19-71

MISSISSIPPI  
BOARD OF WATER COMMISSIONERS  
416 North State Street  
Jackson, Mississippi 39201

WATER WELL DRILLERS LOG

8-19-71 date well completed      Parnell Anderson firm name      Stone county well located

LANDOWNER: H. D. Hall  
Route 1 Perkinston  
(mailing address)

description of formations encountered	from	to
top soil	0	2
Clay	2	12
Clay & Gravel	12	28
Fine Sand	28	34
Pink clay	34	39
SAND	39	48

WELL LOCATION:  
sec. 5 T. 4 N. R. 12 E  
S  
S-E miles 6 of Perkinston  
(distance) (direction) (nearest town)

WELL PURPOSE: Home  
(home, irrigation, municipal, industrial)

- WELL COMPLETION DATA:
- (1) diameter (inches) 2
  - (2) total depth (feet) 48
  - (3) static water level (feet) 30 below above top of ground.
  - (4) casing PVC, 43,  
(material) (depth)  
(size) if telescope see back.
  - (5) screen 5, 43  
(length) (depth to top)  
2, PVC  
(size) (material)
  - (6) pump 1/2, 5  
(HP) (yield gpm)  
Elect  
(type power)
  - (7) electric log \_\_\_\_\_  
(yes or no)  
  
(organization running log)
  - (8) how well bottom plugged Backwash Valve


DRILLERS REMARKS:

AUG 28 1971  
MISS. B.D.  
WATER BOARD

If well telescopes please sketch and show depths.

2000

GROUND LEVEL

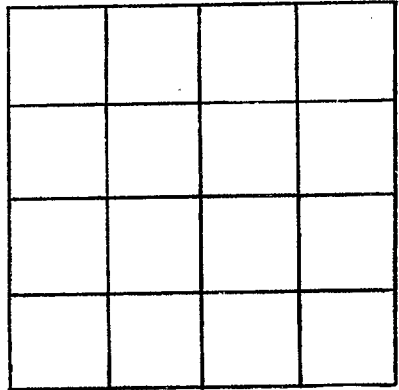

SECTION \_\_\_\_\_

Please indicate well location X.

ADDITIONAL INFORMATION

A series of horizontal lines for recording additional information, starting below the 'ADDITIONAL INFORMATION' header and extending to the bottom of the page.

If more than one screen, show locations of each on sketch.