

STONE
K9
5-73

MISSISSIPPI
BOARD OF WATER COMMISSIONERS
416 North State Street
Jackson, Mississippi 39201

CODED

WATER WELL DRILLERS LOG

19 Samuel Anderson STONE

date well completed _____ firm name _____ county well located _____

LANDOWNER:

Mr C.H. Gore
Mack Henry Miss
(mailing address)

description of formations encountered

Top Soil
White Clay
Coar Sand

from	to
0	4
4	65
65	89

WELL LOCATION:

sec. 14 T. 4 S. R. 12 W.
7 miles west of McKenna
(distance) (direction) (nearest town)

WELL PURPOSE:

Home
(home, irrigation, municipal, industrial)

WELL COMPLETION DATA:

- (1) diameter (inches) 2"
- (2) total depth (feet) 89'
- (3) static water level (feet) 60' below above top of ground.
- (4) casing Plastics, 84',
(material) (depth)
_____ if telescope see back.
(size)
- (5) screen 5', 84'
(length) (depth to top)
2", Plastics
(size) (material)
- (6) pump 1 7
(HP) (yield gpm)
Elect
(type power)
- (7) electric log no
(yes or no)

CODED

(organization running log)

(8) how well bottom plugged
Back with valve


MAY 25 1973

DRILLERS REMARKS:

MIS°

If well telescopes please sketch and show depths.

GROUND LEVEL

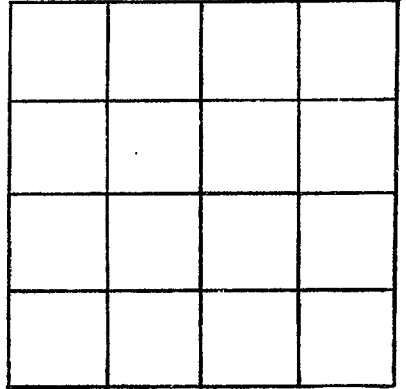

SECTION _____

Please indicate well location X.

ADDITIONAL INFORMATION

If more than one screen, show locations of each on sketch.