

STONE
K 10
1-11-74

MISSISSIPPI
BOARD OF WATER COMMISSIONERS
416 North State Street
Jackson, Mississippi 39201


CODED

WATER WELL DRILLERS LOG

11 JANUARY 1974 BRYANT WELL CO. STONE
date well completed firm name county well located

LANDOWNER: <u>C. W. NORRIS</u>	description of formations encountered	from	to
110 J.F. DOWDLES DR. OCEAN SPRINGS, MS. 39564 (mailing address)			
WELL LOCATION: sec. <u>7</u> T. <u>4</u> N. R. <u>12</u> E. S. W.	YELLOW CLAY	0	10
<u>5</u> miles <u>WEST</u> of <u>METENRY</u> (distance) (direction) (nearest town)	WHITE SAND	10	13
WELL PURPOSE: <u>HOME</u> (home, irrigation, municipal, industrial)	CLAY WITH SAND STREAKS	13	33
WELL COMPLETION DATA:	BLUE CLAY	33	67
(1) diameter (inches) <u>2</u>	FINE SAND	67	96
(2) total depth (feet) <u>157</u>	BLUE SHALE	86	90
(3) static water level (feet) <u>46</u> below top of ground.	COARSE SAND	90	147
(4) casing <u>5/8"</u> <u>147'</u> (material) (depth)	COARSE SAND & GRAVEL	147	157
(size) if telescope see back.	BLUE CLAY	157	172
(5) screen <u>10'</u> <u>008</u> <u>STAINLESS STEEL</u> (length) (depth to top) (size) (material)			
(6) pump <u>1</u> <u>10</u> (HP) (yield gpm)			
<u>ELECTRIC</u> (type power)			
(7) electric log <u>NO</u> (yes or no)			
(organization running log)			
(8) how well bottom plugged <u>BRONZE</u> <u>BACK VALVE</u> <u>VALVE</u>			
DRILLERS REMARKS: <u>NONE</u>			

CODED

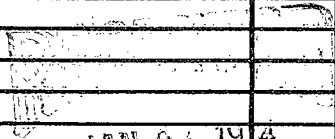


JAN 22 1974

MISS. BD. OF WATER COMMISSIONERS

If well telescopes please sketch and show depths.

GROUND LEVEL

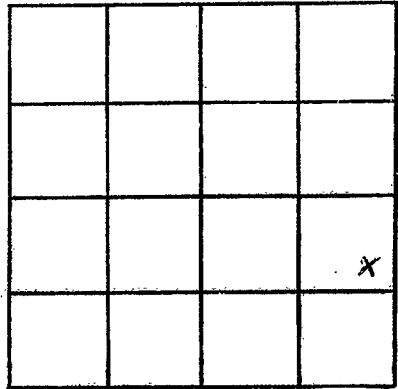

SECTION 7

Please indicate well location X.

ADDITIONAL INFORMATION

If more than one screen,
show locations of each on sketch.