

MISSISSIPPI DEPARTMENT OF NATURAL RESOURCES

Bureau of Land and Water Resources

Southport Mall

P.O. Box 10631

Jackson, Mississippi 39209

WATER WELL DRILLERS LOG

CODED

Stone
K11
10-5-81

BRADEN PUMP AND WELL SERVICE, INC. Stone

10-5-81
date well completed

ROUTE 1, BOX 489
SAUCIER, MS 39574
firm name

county well located

LANDOWNER:
JESS PARKER

description of formations encountered

from

to

McHENRY, Ms.
(mailing address)

SAND	0	10
CLAY	10	200
SAND	200	260

WELL LOCATION:

sec. 12 T 4 N R 12 E
S W

1.0 miles McHenry of
(distance) (direction) (nearest town)

WELL PURPOSE: catfish pond
(home, irrigation, municipal, industrial)

WELL COMPLETION DATA:

- (1) diameter (inches) 4"
- (2) total depth (feet) 260'
- (3) static water level (feet) 188 below above top of ground.

- (4) casing PVC, total 4" (material), (depth) if telescope see back.

- (5) screen 15' 240' (length), (depth to top) 4" PVC underben (size), (material)

- (6) pump S 50 (HP), (yield gpm) 230 (type power)

- (7) electric log NO (yes or no)

(organization running log)

- (8) how well bottom plugged 2" sand shark

DRILLERS REMARKS:
5' tail pipe


CODED

DEPT. OF NATURAL RESOURCES
BUREAU OF LAND & WATER RESOURCES

NOV 16 1981
RECEIVED

If well telescopes please sketch and show depths.

GROUND LEVEL

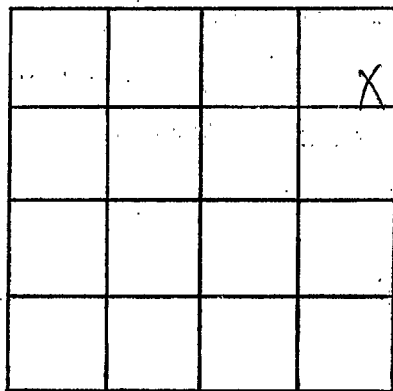

SECTION 12

Please indicate well location X.

ADDITIONAL INFORMATION

If more than one screen, show locations of each on sketch.