

MISSISSIPPI DEPARTMENT OF NATURAL RESOURCES

Bureau of Land and Water Resources

Southport Mall

P.O. Box 10631

Jackson, Mississippi 39209

CODED

WATER WELL DRILLERS LOG

STONE
R12

9-14

St. Frank Price

Stone

date well completed

firm name

county well located

LANDOWNER:

Winnie Flurry

(mailing address)

description of formations encountered

from

to

Top Soil	0	2
Sandy Clay	2	22
Blue Clay	22	310
medium Sand	310	320
Course Sand	320	340

WELL LOCATION:

sec. 24 T 4 S R 12 W
 1 miles S of Henry
 (distance) (direction) (nearest town)

WELL PURPOSE: HOME
 (home, irrigation, municipal, industrial)

WELL COMPLETION DATA:

- (1) diameter (inches) 2"
- (2) total depth (feet) 240'
- (3) static water level (feet) 145' below top of ground.
- (4) casing PVC, 230' (material) (depth)
- (size) If telescope see back.
- (5) screen 10' 230' (length) (depth to top)
- 2 PVC (size) (material)
- (6) pump 2 (HP) 6 (yield gpm)
- Elect (type power)
- (7) electric log NO (yes or no)

CODED

DEPT. OF NATURAL RESOURCES
 BUREAU OF LAND & WATER RESOURCES

NOV 5 1984


RECEIVED

DRILLERS REMARKS:

Bellville

If well telescopes please
sketch and show depths.

GROUND LEVEL

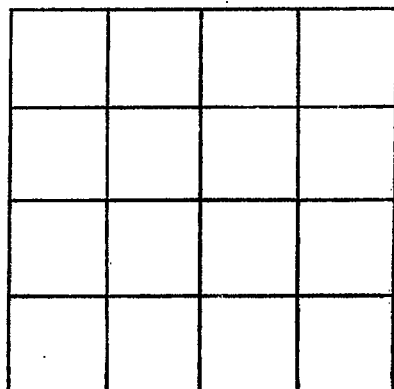

SECTION _____

Please indicate well location X.

ADDITIONAL INFORMATION

If more than one screen,
show locations of each on sketch.