

MISSISSIPPI DEPARTMENT OF NATURAL RESOURCES

Bureau of Land and Water Resources

Southport Mall

P.O. Box 10631

Jackson, Mississippi 39209

WATER WELL DRILLERS LOG

CODED

K 13
STONE
11-1-84

11/1/84 19 Lynner Well Co. Stone
date well completed firm name county well located

LANDOWNER: Jim Cox
Rt. 1, Box 46A
Wiggins, MS 39577
(mailing address)

WELL LOCATION:
sec. 6 T. 4 N. R. 12 E.
13 miles E of Wiggins
(distance) (direction) (nearest town)

WELL PURPOSE: home
(home, irrigation, municipal, industrial)

WELL COMPLETION DATA:

(1) diameter (inches) 4x2

(2) total depth (feet) 817'

(3) static water level (feet) 130' below above top of ground.

(4) casing PVC, 797',
(material) (depth)
4x2 if telescope see back.
(size)

(5) screen 20, 797
(length) (depth to top)
2", PVC
(size) (material)

(6) pump 1 1/2, 20
(HP) (yield gpm)
electric
(type power)

(7) electric log NO
(yes or no)
NO
(organization running log)

(8) how well bottom plugged sand
shark

description of formations encountered	from	to
<u>blue mud</u>	<u>0</u>	<u>280</u>
<u>sandy mud</u>	<u>280</u>	<u>300</u>
<u>blue mud</u>	<u>300</u>	<u>400</u>
<u>sandy mud</u>	<u>400</u>	<u>420</u>
<u>blue mud</u>	<u>420</u>	<u>780</u>
<u>sand</u>	<u>780</u>	<u>817</u>

CODED

DEPT. OF NATURAL RESOURCES
BUREAU OF LAND & WATER RESOURCES


DEC 17 1984

RECEIVED

DRILLERS REMARKS:

If well telescopes please sketch and show depths.

GROUND LEVEL

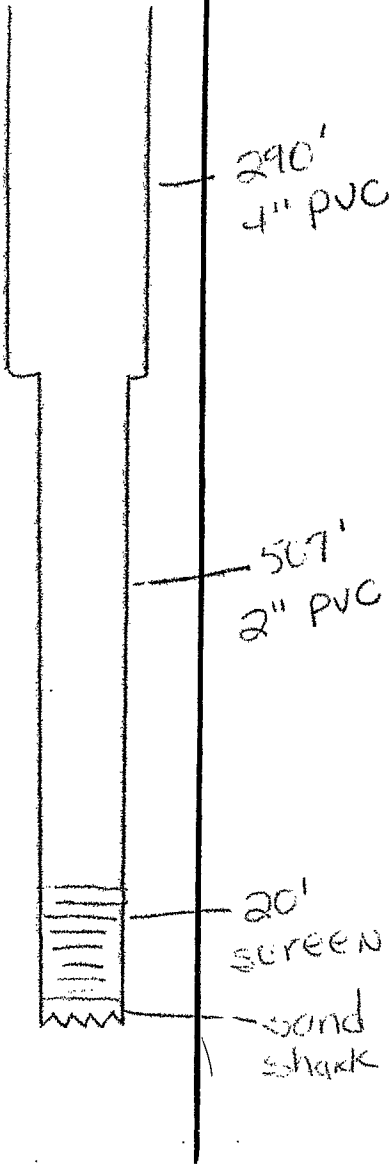

			X

SECTION 6

Please indicate well location X.

ADDITIONAL INFORMATION

If more than one screen, show locations of each on sketch.