	State VI			
County: Stone		ell Report	For Office Use Only:	
	Mississippi Departmen	art 1	Aquifer:	
Permit #:	Office of Land a	Mississippi Department of Environmental Quality Office of Land and Water Resources		
Driller: <u>Lynan</u>	P.O. Box 10631		Well #: K- 43	
Date drilling completed: 12/20/04		IS 39289-0631	L. S. Elevation:	
		961-5210 4-6938 (fax)		
State Law requires that this		· ·	E-log #:	
State Law requires that this repo 30 days of completion of drilling	ort be prepared by the	driller in detail and filed w	ith the Department within	
Well Owner Informa			Location	
Owner Name Gulf Destinations Esterprises Inc				
		Latitude: <u>30 • 43 · 29</u> " Longitude: <u>89 • 11 · 01</u>		
Mailing Address: 409 M. P. Parker Kd		Method of Lat/Long (circle one): Conventional Survey,		
1.0. Box 250				
Meteray . M.S 39561		USGS quad, Hand-held GPS Survey-grade GPS		
City Sta	te Zip Code	NU 14 54 14 Sec 3 Twn 45 Rng/2U		
1-01	Contraction of the second seco		Distance Direction Nearest Town	
	Telephone No. (2018 7/8 - 9675		of	
	Well D			
Purpose of Well (circle one) Home Indu				
Date well drilling started:		Urrigation Fish Culture	Other: <u>105000</u>	
if nowing, method of flow regulation: Val	ve Other (de	scribe)		
Static Water Level: <u>150</u> feet abo	ove or below (circle one) la	and surface Date measured:	12/20/04	
Method of Measurement (circle one) ste	el tape electric tape	air line at a	1-1	
	. 13×0	air line other:		
Hole depth: 1425 Well dep	th:	Well grouted to a depth of	<u>feet</u>	
Type of grout (circle one): Cement	Bentonite Mix			
Casing length: 132 feet Casing	g diameter:	inches Type of assistant	DVC	
Screen length: 60 feet Scree	in diamatan 4	indicids I ype of casing:	pre	
Screen slot size 0/0		_inches Type of screen:	542	
Screen slot size:inches	Setting depth: From	1330 feet to 132	50 feet	
Type of completion (circle all applicable):	Gravel packed Underre	amed Telescoped Open H	note Natural Development	
	Other (describe):	open i	Natural Development	
Top of lap pipe or reduction in casing:	1/1			
		escoped or more than one scree	en, describe on back of page	
Logs run (circle all applicable): No log run	Electric Gamma Ray	Density Sonic Neutron C	Other:	
Name of organization running log(s):	THO V-	-0042		
I certify that the well was drilled, constru- Department of Environmental Quality and	cted, and completed in acc	cordance with all applicable re	Muinomanta of the ball is a	
Department of Environmental Quality and	d/or the Mississippi Depar	rtment of Health regulations	nd state laws	
Josh Ladie	0-6-10		nu state laws,	
Print Name of Water Well Contractor and L		- you	r.o.	
	·	Signature of V	Vater Well Contractor FIVF	
			JAN 1.1 2007	
			BY: OLWF	
,				

-

(601)939-0385

K- 43


## The sheets balon only required for water wells

<u>Rescription of formetions encountered sources for provided for all</u> resils and boreholes, unless specifically complete by rescriptions

If well interested, shere depths on sheeth, Genand Level

Description of Formations Encountered	From (depth)	1010000
	Oppound Lovel	
1CA Sank	0	40
White chairs	40	150
Wellow sand	150	230
placias	230	330
brown Sand	330	420
lelue clar	920	470
brown sand	470	530
6/uceles	1930	580
arac sand	580	620
blue clark	670	760
COArse Sand	960	1060
blue clar ,	1600	1020
mediun Sena	1020	17400
		1
		1
		1
	1	1
	1	

If more than one screen, show location of such or slottsh

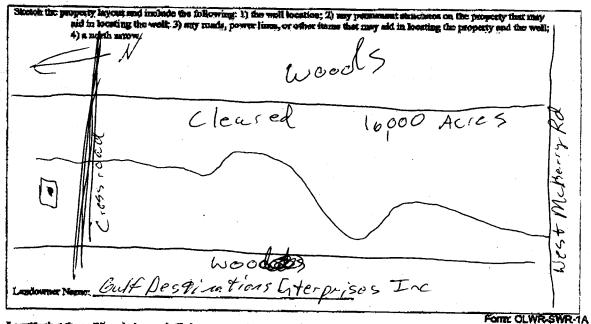

I cartify that the well/bacahole was defined, constructed, and completed in accordance with all applicable requirements of the Mississippi Department of Republicable and state

.05 ne 0 dune of Li

JAN 11 2007 BY: OLWR

· .	STATE WE	ELL REPORT	
County: $5tone$ Permit #: Driller: $Lgnan$ Date completed: $\frac{12}{2005}$	Part 2 Pump Installer's Completion Report Mississippi Department of Environmental Quality Office of Land and Water Resources P.O. Box 10631 Jackson, MS 39289-0631 (601)961-5210 (601)354-6938 (fax)		For Office Use Only:   Aquifer:   Well #: K-43   Elevation:
This report should be prepared by th installation of pump.	e pump installer in detai	l and filed with the Departmer	nt within 30 days of the
Well Owner Informat Owner Name: <u>Galf</u> <u>est</u> Mailing Address: <u>409</u> <u>Mi</u> <u>P</u> , <u>Far</u> <u>Bak</u> <u>2</u> <u>Mchenry</u> <u>M</u> <u>City</u> State Telephone No. <u>(601)</u> <u>928 - 96</u>	<u>intions</u> <u>KerRd</u> <u>50</u> <u>3956</u> ZipCode	Latitude: <u>304379</u> Method of Lat/Long (circle on USGS quad, Hand <u>4</u> Distance Direction	Longitude: <u>9//0/w</u> Longitude: <u>9//0/w</u> he): Conventional Survey, H-held GPS, Survey-grade GPS <u>Twn_45 Rng</u> Nearest Town of
Pump Type Circle one Air Lift Jet	Submersible	C	wer Type ircle one ne Engine Natural Gas
Bucket Piston	Turbine	Electric Motor Hand	Tractor PTO
Centrifugal Rotary	Flowing Well	Windmill Other	(specify):
Other (specify): Date Pump Installed: _/2/20/04 Rated Pump Capacity:5		Horse Power Rating of Motor Setting Depth:C Number of Stages:	
Pump Test Data Date Well Tested:	Below Land Surface	C. Air Line <u>Electric Mea</u>	asuring Water Level incle one suring Line Steel Tape
· · ··································	Below Land Surface Below Land Surface	Other (specify): For flowing well, measured sh	ut in head: NA for
Test Pumping Rate: Duration of Pump Test (minimum 4 hours):	Gallons Per Minute	Well yielded <u>85</u> <u>40</u> feet after _	_GPM with a drawdown of
I HEREBY CERTIFY that the above statem <u>Josh</u> Lame Print Name of Pump Installer and License N	0-640	f my knowledge.	
			RECEIVED
			JAN 11 2007
			BY: OLWR