

STONE
K 2000
2-16-76

MISSISSIPPI
BOARD OF WATER COMMISSIONERS
416 North State Street
Jackson, Mississippi 39201

WATER WELL DRILLERS LOG

2-16-76 date well completed
135 2000 Stone firm name
1920 Stone county well located

LANDOWNER:
Lee M. Kelly
(mailing address)

WELL LOCATION:
sec. 17 T 4 S R 12 E
4 miles W of Meridian
(distance) (direction) (nearest town)

WELL PURPOSE: HOME
(home, irrigation, municipal, industrial)

WELL COMPLETION DATA:
(1) diameter (inches) 2"
(2) total depth (feet) 125'
(3) static water level (feet) 42' below top of ground.
(4) casing Plastic 120' (material) (depth)
(size) if telescope see back.
(5) screen 5' 120' (length) (depth to top)
2" Plastic (size) (material)
(6) pump 1 (HP) 8 (yield gpm)
Elect (type power)
(7) electric log no (yes or no)
(organization running log)
(8) how well bottom plugged Capped


description of formations encountered	from	to
Top Soil	0	2
Clay	2	34
Fine Sand	34	50
Blue Clay	40	62
Flint Sand	60	110'
Coarse Sand	100	125'

RECEIVED
MAR 3 1976

DRILLERS REMARKS:

If well telescopes please sketch and show depths.

GROUND LEVEL

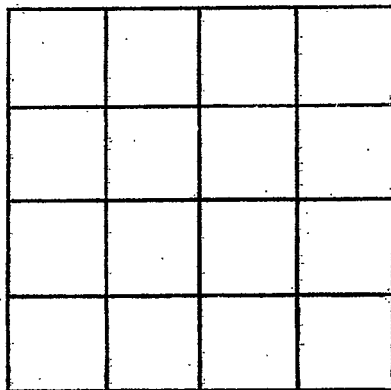

SECTION _____

Please indicate well location X.

ADDITIONAL INFORMATION

If more than one screen, show locations of each on sketch.