

STONE
K 2000
2-8-78

MISSISSIPPI
BOARD OF WATER COMMISSIONERS
416 North State Street
Jackson, Mississippi 39201

WATER WELL DRILLERS LOG

2/8/78 19 Coast Drilling Stone
date well completed firm name county well located
Biloxi Miss.

LANDOWNER Wm. Plummer
Biloxi Miss
McKenny John
(mailing address)

description of formations encountered	from	to
	top soil	1
Red Clay	2	12
Coarse white sand	12	30
glaucon	30	45
Red Clay	45	60
Soft Blue Clay	60	110
fine white sand	110	125
Coarse white sand	125	150

WELL LOCATION:
sec. 11 T 4 N R 12 E
S W
1/2 mile(s) west of McKenny
(distance) (direction) (nearest town)

WELL PURPOSE: private
(home, irrigation, municipal, industrial)

WELL COMPLETION DATA:
(1) diameter (inches) 8"
(2) total depth (feet) 150'
(3) static water level (feet) 60 below above top of ground.
(4) casing PVC 140'
(material) (depth)
(size) if telescope see back.
(5) screen 10' 140'
(length) (depth to top)
2" PVC
(size) (material)
(6) pump one 10
(HP) (yield gpm)
3/4
(type power)
(7) electric log no
(yes or no)
(organization running log)

(8) how well bottom plugged
2' backwash valve

DRILLERS REMARKS:


RECEIVED

MAY 5 - 1978

OF WATER COM

If well telescopes please sketch and show depths.

GROUND LEVEL

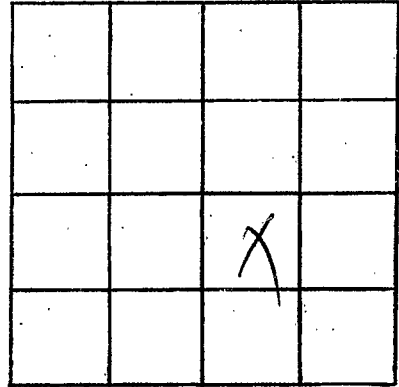

SECTION _____

Please indicate well location X.

ADDITIONAL INFORMATION

If more than one screen, show locations of each on sketch.