

Stone
K 2002
3/16/78

MISSISSIPPI
BOARD OF WATER COMMISSIONERS
416 North State Street
Jackson, Mississippi 39201

WATER WELL DRILLERS LOG

3-16 1978 Arnold Anderson Stone
date well completed firm name county well located

LANDOWNER:	description of formations encountered	from	to
<u>Gene Alexander</u>	<u>Top Soil</u>	<u>0</u>	<u>2</u>
(mailing address)	<u>Blue Clay</u>	<u>2</u>	<u>95</u>
WELL LOCATION:	<u>Fine Sand</u>	<u>95</u>	<u>130</u>
sec. <u>11</u> T. <u>4</u> N. R. <u>12</u> S. W. <u>2</u> miles <u>W</u> of <u>McHenry</u> (distance) (direction) (nearest town)	<u>Course Sand</u>	<u>130</u>	<u>145</u>
WELL PURPOSE: <u>HOME</u> (home, irrigation, municipal, industrial)			
WELL COMPLETION DATA:			
(1) diameter (inches) <u>2"</u>			
(2) total depth (feet) <u>145'</u>			
(3) static water level (feet) <u>58</u> below top of ground.			
(4) casing <u>Plastic 140'</u> (material) (depth)			
_____ if telescope see back. (size)			
(5) screen <u>5'</u> , <u>140'</u> (length) (depth to top)			
<u>2"</u> , <u>Plastic</u> (size) (material)			
(6) pump <u>1</u> , <u>11</u> (HP) (yield gpm)			
<u>Elect</u> (type power)			
(7) electric log <u>no</u> (yes or no)			
_____ (organization running log)			
(8) how well bottom plugged <u>Capped</u>			
DRILLERS REMARKS:			


RECEIVED

APR - 7 1978

MISS. BD. OF WATER COMMISSIONERS

If well telescopes please sketch and show depths.

GROUND LEVEL

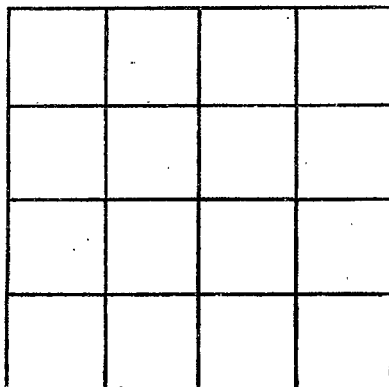

SECTION _____

Please indicate well location X.

ADDITIONAL INFORMATION

If more than one screen, show locations of each on sketch.