

Stone
K 2005
5-6-80

MISSISSIPPI
BOARD OF WATER COMMISSIONERS
416 North State Street
Jackson, Mississippi 39201

WATER WELL DRILLERS LOG

5-6 1980 Pennell Anderson Stone
date well completed firm name county well located

LANDOWNER:	description of formations encountered	from	to
<u>A. D. Butler</u>			
(mailing address)	<u>Course Sand</u>	<u>2</u>	<u>45</u>
WELL LOCATION:	<u>Blue Clay</u>	<u>45</u>	<u>95</u>
sec. <u>7</u> T. <u>4</u> R. <u>15</u>	<u>Course Sand</u>	<u>95</u>	<u>130</u>
<u>3 1/2</u> miles <u>W</u> of <u>McHenry</u>			
(distance) (direction) (nearest town)			
WELL PURPOSE: <u>HOME</u>			
(home, irrigation, municipal, industrial)			
WELL COMPLETION DATA:			
(1) diameter (inches) <u>2"</u>			
(2) total depth (feet) <u>130</u>			
(3) static water level (feet) <u>28'</u> below top of ground.			
(4) casing <u>Plastic 115'</u>			
(material) (depth)			
(size) if telescope see back:			
(5) screen <u>5"</u> , <u>115'</u>			
(length) (depth to top)			
<u>5"</u> , <u>Plastic</u>			
(size) (material)			
(6) pump <u>1</u> <u>11</u>			
(HP) (yield gpm)			
<u>Elect</u>			
(type power)			
(7) electric log <u>NO</u>			
(yes or no)			
(organization running log)			
(8) how well bottom plugged <u>Capped</u>			

DRILLERS REMARKS:


DEPT. OF NATURAL RESOURCES
BUREAU OF LAND & WATER RESOURCES

JUN 4 - 1980

RECEIVED

If well telescopes please sketch and show depths.

GROUND LEVEL

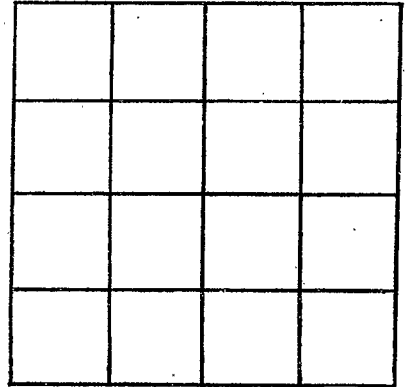

SECTION _____

Please indicate well location X.

ADDITIONAL INFORMATION

If more than one screen,
show locations of each on sketch.