

STONE
K2000
8-15-80

MISSISSIPPI
BOARD OF WATER COMMISSIONERS
416 North State Street
Jackson, Mississippi 39201

WATER WELL DRILLERS LOG

8-15-1980 Larnee Anderson Stone
date well completed firm name county well located

LANDOWNER: Logan York
113 Shady Grove
Perkinsville, MS
(mailing address)

WELL LOCATION:
sec. 10 T 4 N R 13 E
S W
4 miles W of McHenry
(distance) (direction) (nearest town)

WELL PURPOSE: Home
(home, irrigation, municipal, industrial)

WELL COMPLETION DATA:
(1) diameter (inches) 2"
(2) total depth (feet) 168'
(3) static water level (feet) _____ below above top of ground.
(4) casing Plastic 80
(material) (depth)
_____ If telescope see back.
(size)
(5) screen 5" 80
(length) (depth to top)
_____ (size) _____ (material)
(6) pump 1 10
(HP) (yield gpm)
Electric
(type power)
(7) electric log NO
(yes or no)
_____ (organization running log)
(8) how well bottom plugged Capped

description of formations encountered	from	to
<u>Top soil</u>	<u>0</u>	<u>3</u>
<u>Sand fine</u>	<u>3</u>	<u>30</u>
<u>Clay</u>	<u>30</u>	<u>124</u>
<u>Fine Sand</u>	<u>124</u>	<u>148</u>
<u>Coarse Sand</u>	<u>148</u>	<u>168</u>

DEPT. OF NATURAL RESOURCES
BUREAU OF LAND & WATER RESOURCES


OCT 14 1980

RECEIVED

DRILLERS REMARKS:

If well telescopes please sketch and show depths.

GROUND LEVEL

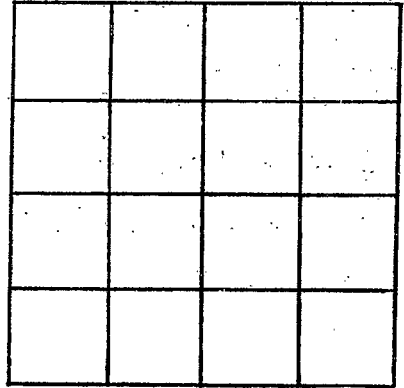

SECTION _____

Please indicate well location X.

ADDITIONAL INFORMATION

If more than one screen,
show locations of each on sketch.