

STONE

K 2007

12-18-80

12-18

date well completed

MISSISSIPPI
BOARD OF WATER COMMISSIONERS
416 North State Street
Jackson, Mississippi 39201

WATER WELL DRILLERS LOG

1980 Farnell Anderson

Stone
county well located

LANDOWNER:

Billy Joe Willis

description of formations encountered

from

to

Rt 1 Box 221

McHenry MS 39561

(mailing address)

top soil

0 3

clay

3 16

Fine Sand

16 28

Blue Clay

28 85

clay

85 92

Fine Sand

92 130

Coarse Sand

130 150

WELL LOCATION:

sec. 3 T 4 S R 12 W

4 miles W of McHenry (distance) (direction) (nearest town)

WELL PURPOSE:

home (home, irrigation, municipal, industrial)

WELL COMPLETION DATA:

(1) diameter (inches) 2"

(2) total depth (feet) 150'

(3) static water level (feet) 55' below top of ground.

(4) casing: Plastic 145' (material) (depth)

2" (size) if telescope see back.

(5) screen 5' 145' (length) (depth to top)

2" Plastic (size) (material)

(6) pump 1 9 (HP) (yield gpm)

Submersible (type power)

(7) electric log NO (yes or no)

(organization running log)

(8) how well bottom plugged Capped

DRILLERS REMARKS:


DEPT. OF NATURAL RESOURCES
BUREAU OF LAND & WATER RESOURCES

JAN 12 1981

RECEIVED

If well telescopes please sketch and show depths.

GROUND LEVEL

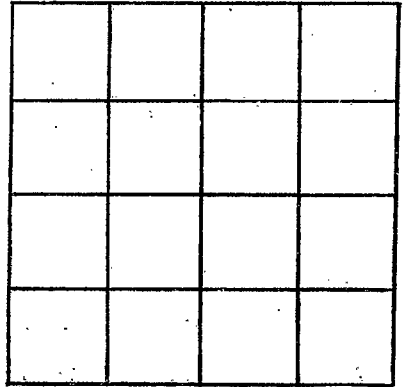

SECTION _____

Please indicate well location X.

ADDITIONAL INFORMATION

If more than one screen,
show locations of each on sketch.