

MISSISSIPPI DEPARTMENT OF NATURAL RESOURCES

Bureau of Land and Water Resources

Southport Mall

P.O. Box 10631

Jackson, Mississippi 39209

WATER WELL DRILLERS LOG

11

Stone
K 2008

1/6/81
1-6-81

19 Parnee Anderson
firm name

Stone
county well located

LANDOWNER: Raymond Ward

description of formations encountered

from

to

Pt 2, Box 77
Shreveport, MS 39501
(mailing address)

<u>Top soil</u>	<u>0</u>	<u>3</u>
<u>Sandy clay</u>	<u>3</u>	<u>28</u>
<u>Fine sand</u>	<u>28</u>	<u>40</u>
<u>Blue clay</u>	<u>40</u>	<u>120</u>
<u>Sand</u>	<u>120</u>	<u>148</u>

WELL LOCATION:

sec. 10 T. 4 N R. 12 E
3 miles W of McHenry
(distance) (direction) (nearest town)

WELL PURPOSE: home
(home, irrigation, municipal, industrial)

WELL COMPLETION DATA:

- (1) diameter (inches) 2"
- (2) total depth (feet) 148'
- (3) static water level (feet) 76' below top of ground.
- (4) casing PVC, 143'
(material), (depth)
- (size) if telescope see back.
- (5) screen 51, 143'
(length), (depth to top)
- 2", PVC
(size), (material)
- (6) pump 1, 10
(HP), (yield gpm)
- Electric
(type power)
- (7) electric log NO
(yes or no)

(organization running log)

(8) how well bottom plugged yes

DRILLERS REMARKS:

DEPT. OF NATURAL RESOURCES
BUREAU OF LAND & WATER RESOURCES


MAY 18 1981

RECEIVED

SECTIONS

If well telescopes please sketch and show depths.

GROUND LEVEL

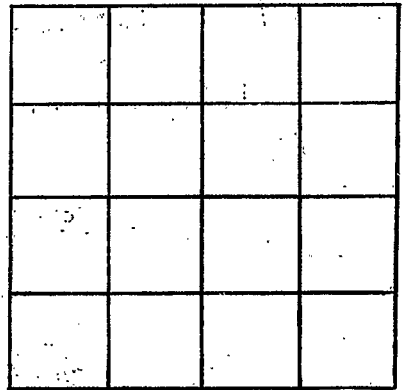

SECTION _____

Please indicate well location X.

ADDITIONAL INFORMATION

If more than one screen, show locations of each on sketch.