

MISSISSIPPI DEPARTMENT OF NATURAL RESOURCES

Bureau of Land and Water Resources

Southport Mall

P.O. Box 10631

Jackson, Mississippi 39209

WATER WELL DRILLERS LOG

Stone
Kaosa

5-6 1982
date well completed

82 Frank Pines
firm name

Stone
county well located

LANDOWNER:
Ray Kittrell

(mailing address)

description of formations encountered	from	to
Top Soil	0	2
Clay	2	96
Hard Sand	96	110

WELL LOCATION:
sec. 17 T. 4 N. R. 12 E
4 1/2 miles ^{SW} of McNem
(distance) (direction) (nearest town)

WELL PURPOSE: HOME
(home, irrigation, municipal, industrial)

- WELL COMPLETION DATA:
- (1) diameter (inches) 2"
 - (2) total depth (feet) 110'
 - (3) static water level (feet) 44 below top of ground
 - (4) casing Plastic, 105'
(material) (depth)
 if telescope see back.
(size)
 - (5) screen 5', 105'
(length) (depth to top)
2", Plastic
(size) (material)
 - (6) pump 1 3
(HP) (yield gpm)
Elect
(type power)
 - (7) electric log no
(yes or no)

Bad well

(organization running log)

(8) how, with bottom plugged Back in last well

DRILLERS REMARKS:


DEPT. OF NATURAL RESOURCES
BUREAU OF LAND & WATER RESOURCES

JUN 15 1982

RECEIVED

If well telescopes please sketch and show depths.

GROUND LEVEL

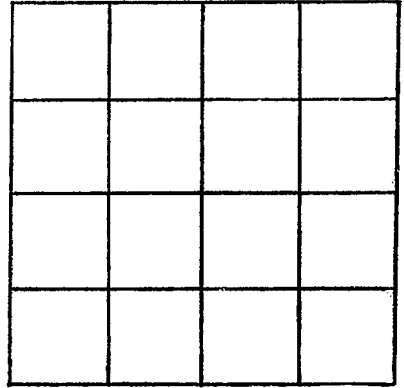

SECTION _____

Please indicate well location X.

ADDITIONAL INFORMATION

If more than one screen, show locations of each on sketch.