

MISSISSIPPI DEPARTMENT OF NATURAL RESOURCES
Bureau of Land and Water Resources
 Southport Mall
 P.O. Box 10631
 Jackson, Mississippi 39209
WATER WELL DRILLERS LOG

Stone
R
2011

9-30 1982 Furb Price Stone
 date well completed firm name county well located

LANDOWNER:
Judge Brown
 (mailing address)

description of formations encountered	from	to
<u>Top Soil</u>	<u>0</u>	<u>3</u>
<u>Clay</u>	<u>3</u>	<u>95</u>
<u>Coarse Sand</u>	<u>95</u>	<u>145</u>

WELL LOCATION:
 sec 10 T 4 S R 12 W
3 miles W of McHenry
 (distance) (direction) (nearest town)

WELL PURPOSE: HOME
 (home, irrigation, municipal, industrial)

WELL COMPLETION DATA:

(1) diameter (inches) 2"

(2) total depth (feet) 145'

(3) static water level (feet) 60' below above top of ground.

(4) casing Plastic, 140'
 (material) (depth)

_____ if telescope see back.
 (size)

(5) screen 5', 140'
 (length) (depth to top)

2", Plastic
 (size) (material)

(6) pump 1 8
 (HP) (yield gpm)

2 sect
 (type power)

(7) electric log no
 (yes or no)

_____ (organization running log)

(8) how well bottom plugged Bottom valve


DRILLERS REMARKS:

DEPT. OF NATURAL RESOURCES
 BUREAU OF LAND & WATER RESOURCES

OCT - 5 1982
RECEIVED

If well telescopes please sketch and show depths.

GROUND LEVEL

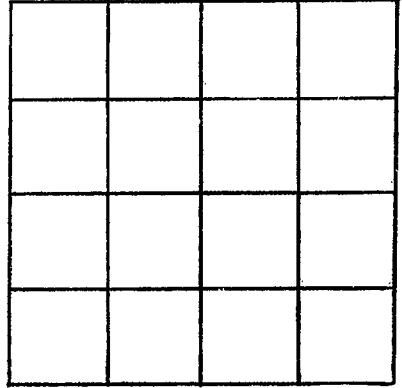

SECTION _____

Please indicate well location X.

ADDITIONAL INFORMATION

If more than one screen,
show locations of each on sketch.