

Stone  
K 2012

MISSISSIPPI  
BOARD OF WATER COMMISSIONERS  
416 North State Street  
Jackson, Mississippi 39201

WATER WELL DRILLERS LOG

Feb 28 1983 Farness Anderson Stone  
date well completed firm name county well located

LANDOWNER: James Rabby

description of formations encountered

from to

Qtz 3  
Perkinston, MS  
(mailing address)

top soil	0	2
Clay	2	15
sand	15	32
Clay	32	40
Sand	40	58

WELL LOCATION:

sec 3 T 4 R 11  
S W  
6 miles SS of Perkinston  
(distance) (direction) (nearest town)

WELL PURPOSE: Home  
(home, irrigation, municipal, industrial)

WELL COMPLETION DATA:

- (1) diameter (inches) 2"
- (2) total depth (feet) 58'
- (3) static water level (feet) 40' below top of ground.
- (4) casing PVC  
(material) (depth)  
         if telescope see back.  
(size)
- (5) screen 5' 53'  
(length) (depth to top)  
2' PVC  
(size) (material)
- (6) pump 1 11  
(HP) (yield gpm)  
Electric  
(type power)
- (7) electric log NO  
(yes or no)  
          
(organization running log)
- (8) how well bottom plugged Capped

DEPT OF NATURAL RESOURCES  
BUREAU OF LAND & WATER RESOURCES


JUN - 2 1983

DRILLERS REMARKS:

RECEIVED

If well telescopes please sketch and show depths.

GROUND LEVEL

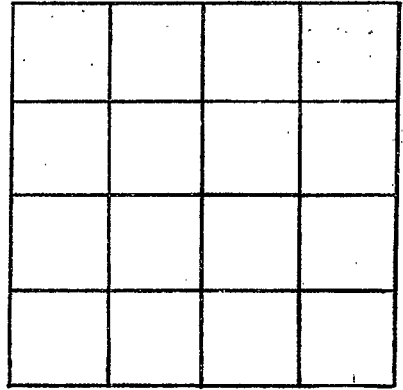

SECTION \_\_\_\_\_

Please indicate well location X.

ADDITIONAL INFORMATION

If more than one screen, show locations of each on sketch.