

MISSISSIPPI DEPARTMENT OF NATURAL RESOURCES

Bureau of Land and Water Resources

Southport Mall

P.O. Box 10631

Jackson, Mississippi 39209

WATER WELL DRILLERS LOG

Stone
K 2013

5-2
date well completed

1983 Frank Price
firm name

Stone
county well located

LANDOWNER:
Daniel Frisella

(mailing address)

description of formations encountered	from	to
<u>Top Soil</u>	<u>0</u>	<u>3</u>
<u>Clay</u>	<u>3</u>	<u>68</u>
<u>medium sand</u>	<u>68</u>	<u>85</u>

WELL LOCATION:
sec. 9 T. 4 S. R. 12 E.
3 1/2 miles W of McBury
(distance) (direction) (nearest town)

WELL PURPOSE: AGRI
(home, irrigation, municipal, industrial)

- WELL COMPLETION DATA:
- (1) diameter (inches) 2"
 - (2) total depth (feet) 85
 - (3) static water level (feet) 53 below top of ground.
 - (4) casing Plastic, 80'
(material) (depth)
2" if telescope see back.
(size)
 - (5) screen 5', 80'
(length) (depth to top)
2", Plastic
(size) (material)
 - (6) pump 1 10
(HP) (yield gpm)
Elect
(type power)
 - (7) electric log no
(yes or no)

(organization running log)
 - (8) no well bottom plugged
Ball

DRILLERS REMARKS:


DEPT. OF NATURAL RESOURCES
BUREAU OF LAND & WATER RESOURCES

JUN 20 1983

RECEIVED

If well telescopes please sketch and show depths.

GROUND LEVEL

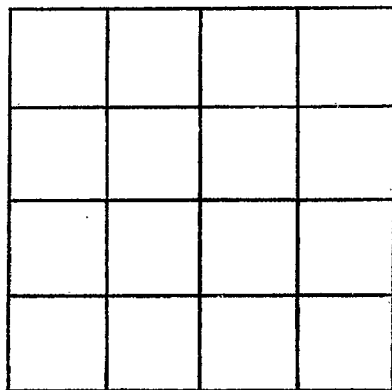

SECTION _____

Please indicate well location X.

ADDITIONAL INFORMATION

If more than one screen, show locations of each on sketch.