

MISSISSIPPI DEPARTMENT OF NATURAL RESOURCES

Bureau of Land and Water Resources

Southport Mall

P.O. Box 10631

Jackson, Mississippi 39209

WATER WELL DRILLERS LOG

Stone  
K2014

10-20 1983 Frank Price Stone  
date well completed firm name county well located

LANDOWNER:	description of formations encountered	from	to
Billy Ray Warden			
(mailing address)	Clay	3	100
WELL LOCATION:	Course Sand	100	130
sec. 9 T 4 S R 12 E			
3 miles W of HWY 49			
WELL PURPOSE: HOME			
(home, irrigation, municipal, industrial)			
WELL COMPLETION DATA:			
(1) diameter (inches) 2"			
(2) total depth (feet) 130'			
(3) static water level (feet) 50' below top of ground.			
(4) casing Plastic 125' (material) (depth)			
(size) If telescope see back.			
(5) screen 5' 125' (length) (depth to top)			
2" Plastic (size) (material)			
(6) pump 1 10 (HP) (yield gpm)			
Elect (type power)			
(7) electric log no (yes or no)			
(organization running log)			
(8) how well bottom plugged B.W.V.			
DRILLERS REMARKS:			


DEPT. OF NATURAL RESOURCES  
BUREAU OF LAND & WATER RESOURCES

NOV 28 1983

RECEIVED

If well telescopes please sketch and show depths.

GROUND LEVEL

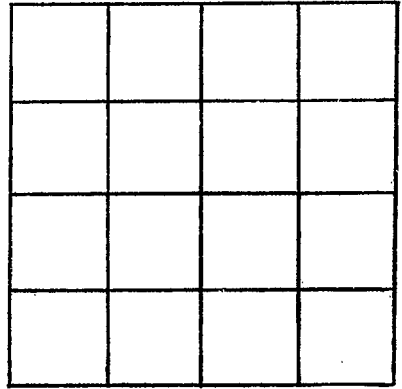

SECTION \_\_\_\_\_

Please indicate well location X.

ADDITIONAL INFORMATION

If more than one screen, show locations of each on sketch.