

MISSISSIPPI DEPARTMENT OF NATURAL RESOURCES

Bureau of Land and Water Resources

Southport Mall

P.O. Box 10631

Jackson, Mississippi 39209

WATER WELL DRILLERS LOG

Stone
K 2015

3-6
date well completed

1984 Frank Price
firm name

Stone
county well located

LANDOWNER:
Alfred Ladnier

(mailing address)

description of formations encountered	from	to
<u>Top Soil</u>	<u>0</u>	<u>2</u>
<u>white clay</u>	<u>2</u>	<u>130</u>
<u>Coarse Sand</u>	<u>130</u>	<u>145</u>

WELL LOCATION:
sec 10 T 4 R 12
S W
3 miles W of McAdams
(distance) (direction) (nearest town)

WELL PURPOSE: HOME
(home, irrigation, municipal, industrial)

WELL COMPLETION DATA:

(1) diameter (inches) 2"

(2) total depth (feet) 145'

(3) static water level (feet) 80' below above top of ground.

(4) casing PVC, 140'
(material) (depth)

if telescope see back.
(size)

(5) screen 5', 140'
(length) (depth to top)
2, PVC
(size) (material)

(6) pump 1 8
(HP) (yield gpm)
Elect
(type power)

(7) electric log NO
(yes or no)

(organization running log)

(8) how well bottom plugged B.W.V.

DRILLERS REMARKS:


DEPT. OF NATURAL RESOURCES
BUREAU OF LAND & WATER RESOURCES

APR 10 1984

RECEIVED

If well telescopes please sketch and show depths.

GROUND LEVEL

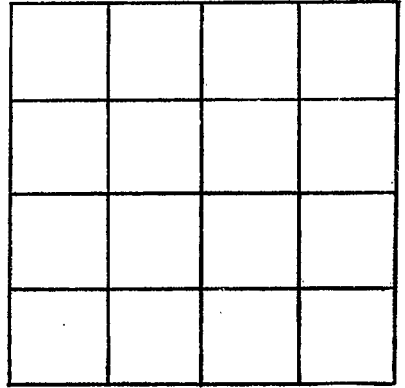

SECTION _____

Please indicate well location X.

ADDITIONAL INFORMATION

If more than one screen,
show locations of each on sketch.