

MISSISSIPPI DEPARTMENT OF NATURAL RESOURCES

Bureau of Land and Water Resources

Southport Mall

P.O. Box 10631

Jackson, Mississippi 39209

WATER WELL DRILLERS LOG

STONE
R
2014

8-10
date well completed

84 Frank Price
firm name

Stone
county well located

LANDOWNER:
Somas Ogbum

(mailing address)

description of formations encountered	from	to
<u>Top Soil</u>	<u>0</u>	<u>3</u>
<u>Clay</u>	<u>3</u>	<u>82</u>
<u>Medium Sand</u>	<u>82</u>	<u>103</u>

WELL LOCATION:
sec. 9 T 4 S R 12 W
3 miles W of McHenry
(distance) (direction) (nearest town)

WELL PURPOSE: HOME
(home, irrigation, municipal, industrial):

- WELL COMPLETION DATA:
- (1) diameter (inches) 2"
 - (2) total depth (feet) 103'
 - (3) static water level (feet) 40' below top of ground.
 - (4) casing PVC, 98'
(material) (depth)
 - if telescope see back.
(size)
 - (5) screen 5', 98'
2" (length) (depth to top)
 , PVC
(size) (material)
 - (6) pump 1, 10
(HP) (yield gpm)
Elect
(type power)
 - (7) electric log no
(yes or no)
 - (organization running log)
 - (8) how well bottom plugged BWV


DRILLERS REMARKS:

DEPT. OF NATURAL RESOURCES
BUREAU OF LAND & WATER RESOURCES

SEP - 7 1984
RECEIVED

If well telescopes please sketch and show depths.

GROUND LEVEL

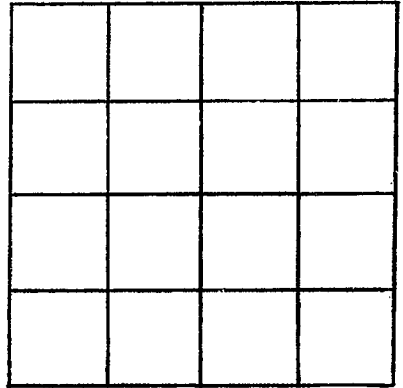

SECTION _____

Please indicate well location X.

ADDITIONAL INFORMATION

If more than one screen,
show locations of each on sketch.