

MISSISSIPPI DEPARTMENT OF NATURAL RESOURCES

Bureau of Land and Water Resources

Southport Mall

P.O. Box 10631

Jackson, Mississippi 39209

WATER WELL DRILLERS LOG

Stone  
K2007

August 31 1984 Braden Pump Well Dr. Stone  
date well completed firm name county well located

LANDOWNER:  
Randy Moran  
231 West Pearl  
Wiggins, Mo (mailing address) 39572  
WELL LOCATION:  
sec. 18 T. 4 S. R. 12 E.  
5 miles W of McHenry  
(distance) (direction) (nearest town)

description of formations encountered	from	to
<u>Red Sandy Clay</u>	<u>0</u>	<u>10</u>
<u>White Clay and lenses</u>	<u>10</u>	<u>20</u>
<u>Blue Clay</u>	<u>20</u>	<u>220</u>
<u>Green fine sand</u>	<u>220</u>	<u>234</u>
<u>Blue Clay</u>	<u>234</u>	<u>270+</u>

WELL PURPOSE: Home  
(home, irrigation, municipal, industrial)

WELL COMPLETION DATA:

(1) diameter (inches) 2

(2) total depth (feet) 270

(3) static water level (feet) 60 below above top of ground.

(4) casing PVC 270  
(material) (depth)  
2" If telescope see back.  
(size)

(5) screen 5FT 225  
(length) (depth to top)  
2" PVC-Underbar  
(size) (material)

(6) pump 1 8  
(HP) (yield gpm)  
270 v 1/2  
(type power)

(7) electric log No  
(yes or no)  
(organization running log)

(8) how well bottom plugged  
2" PVC sand shark

DRILLERS REMARKS:  
40FT Tailpipe


DEPT. OF NATURAL RESOURCES  
BUREAU OF LAND & WATER RESOURCES

SEP 18 1984

RECEIVED

If well telescopes please sketch and show depths.

GROUND LEVEL

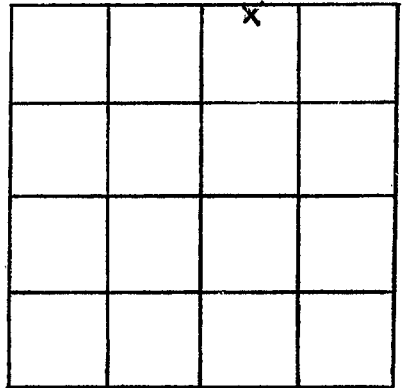

SECTION 18

Please indicate well location X.

ADDITIONAL INFORMATION

If more than one screen,  
show locations of each on sketch.