

MISSISSIPPI DEPARTMENT OF NATURAL RESOURCES

Bureau of Land and Water Resources

Southport Mall

P.O. Box 10631

Jackson, Mississippi 39209

WATER WELL DRILLERS LOG

STONE
K 2018

3-12 date well completed 19 86 Parwell Anderson firm name Stone county well located


LANDOWNER: Bobby Cobb
 RT 1 McHenry
 Miss
 (mailing address)

description of formations encountered	from	to
Top Soil	0	2
Clay	2	26
SAND	26	33
Clay	33	105
SAND	105	125

WELL LOCATION:
 sec. 2 T. 4 N. R. 12 W.
 S W
 4 miles W of McHenry
 (distance) (direction) (nearest town)

WELL PURPOSE: Home
 (home, irrigation, municipal, industrial)

- WELL COMPLETION DATA:
- (1) diameter (inches) 2
 - (2) total depth (feet) 125
 - (3) static water level (feet) 55 below top of ground.
 - (4) casing PVC, 120, (material) (depth)
 - (size) if telescope see back.
 - (5) screen 5, 120 (length) (depth to top)
 - 3, PVC (size) (material)
 - (6) pump 1, 9 (HP) (yield gpm).
 - Elec (type power)
 - (7) electric log NO (yes or no)
 - (organization running log)
 - (8) how well bottom plugged Cap

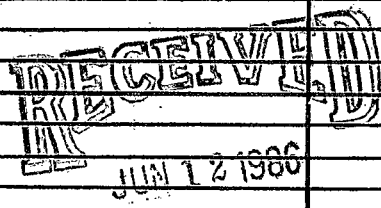


Department of Natural Resources
 Bureau of Land & Water Resources

DRILLERS REMARKS:

If well telescopes please sketch and show depths.

GROUND LEVEL

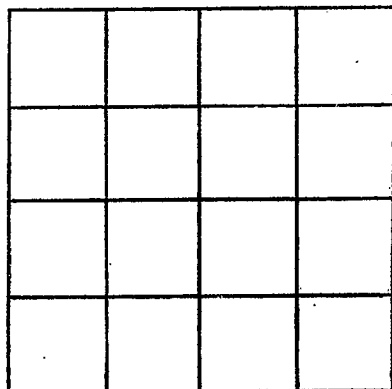

SECTION _____

Please indicate well location X.

ADDITIONAL INFORMATION

If more than one screen,
show locations of each on sketch.