

MISSISSIPPI DEPARTMENT OF NATURAL RESOURCES

Bureau of Land and Water Resources

Southport Mall

P.O. Box 10631

Jackson, Mississippi 39209

WATER WELL DRILLERS LOG

STONE
K 2019

7-23
date well completed

1986
firm name

Stone
county well located

LANDOWNER:
Mary Williams

(mailing address)


description of formations encountered	from	to
<u>Top Soil</u>	<u>0</u>	<u>2</u>
<u>Red Clay</u>	<u>2</u>	<u>18</u>
<u>Coarse Sand</u>	<u>18</u>	<u>35</u>

WELL LOCATION:
sec 2 T 4 S R 12 W
2 1/2 miles SE. of McHenry
(distance) (direction) (nearest town)

WELL PURPOSE: HOME
(home, irrigation, municipal, industrial)

- WELL COMPLETION DATA:
- (1) diameter (inches) 2"
 - (2) total depth (feet) 35'
 - (3) static water level (feet) 5' below top of ground.
 - (4) casing PVC, 30'
(material) (depth)
(size) if telescope see back.
 - (5) screen 5', 30'
(length) (depth to top)
2", PVC
(size) (material)
 - (6) pump 1 (HP) (yield gpm)
Elect
(type power)
 - (7) electric log no
(yes or no)
 - (organization running log)
 - (8) how well bottom plugged B.W.V.

DRILLERS REMARKS:

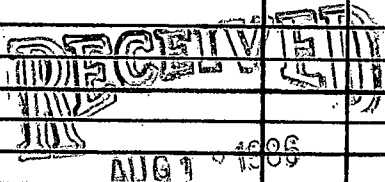

Department of Natural Resources
Bureau of Land and Water Resources

