

CODED

CODED

CODED

CODED

MISSISSIPPI
 BOARD OF WATER COMMISSIONERS
 416 North State Street
 Jackson, Mississippi 39201

WATER WELL DRILLERS LOG

Stone
L4
10-1-68

10-1 1968 L. W. Smith Stone
 date well completed firm name county well located

LANDOWNER:

Travis Parsons

Perkingster

(mailing address)

description of formations encountered

Tap
Clay
Sand
Clay

| from | to |
|-------------|------------|
| <u>0</u> | <u>1</u> |
| <u>1.00</u> | <u>6.0</u> |
| <u>6.0</u> | <u>8.5</u> |

WELL LOCATION:

sec. 6 T 4 S R 11 W
4 miles N of McHenry
 (distance) (direction) (nearest town)

WELL PURPOSE:

(home, irrigation, municipal, industrial)

WELL COMPLETION DATA:

- (1) diameter (inches) 2"
- (2) total depth (feet) 85
- (3) static water level (feet) 50 below above top of ground.
- (4) casing Plastic 85 (material) (depth)
- (size) If telescope see back.
- (5) screen 5' 80 (length) (depth to top)
- 2" Plastic (size) (material)
- (6) pump 1 12 (HP) (yield gpm)
- Electric (type power)
- (7) electric log _____ (yes or no)

(organization running log)

- (8) how well bottom plugged Back w.

DRILLERS REMARKS:


CODED

REC 4 1969

MISS. BU. OF WATER CONTROL

If well telescopes please sketch and show depths.

GROUND LEVEL

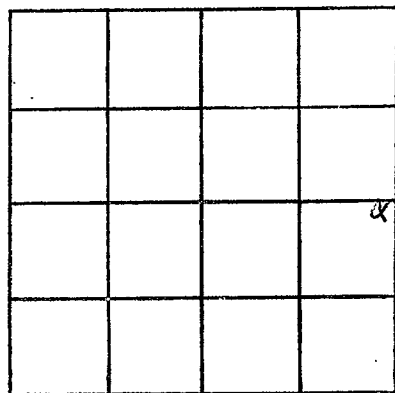

SECTION 6

Please indicate well location X.

ADDITIONAL INFORMATION

If more than one screen, show locations of each on sketch.