

STONE

~~HARRISON~~
L6
4-8-70

MISSISSIPPI
BOARD OF WATER COMMISSIONERS
416 North State Street
Jackson, Mississippi 39201

CODED

WATER WELL DRILLERS LOG

4-8
date well completed

19 Parvell Anderson
firm name

~~HARRISON~~
county well located

LANDOWNER: Willie E Robinson
McHenry
(mailing address)

WELL LOCATION:
sec. 24 T. 5 S. R. 11 E.
7 miles E of McHenry
(distance) (direction) (nearest town)

WELL PURPOSE:
(home, irrigation, municipal, industrial)

- WELL COMPLETION DATA:
- (1) diameter (inches) 2
 - (2) total depth (feet) 304
 - (3) static water level (feet) 140 below above top of ground.
 - (4) casing Plas 299
(material) (depth)
 - (5) screen 5' 299
(length) (depth to top)
2 Plastic
(size) (material)
 - (6) pump 1 4
(HP) (yield gpm)
Elect
(type power)
 - (7) electric log _____
(yes or no)
 - _____
(organization running log)
 - (8) how well bottom plugged
Backwash valve

description of formations encountered	from	to
Top Soil	0	3
Red Clay	3	26
Fine Sand	26	34
White Clay	34	42
Blue Clay	42	168
Fine Sand	168	189
Blue Clay	189	260
Fine Sand	260	278
Coarse Sand	278	304

CODED


JUN 11 1970

MISS. RD. OF
WATER COMM.

DRILLERS REMARKS:

If well telescopes please sketch and show depths.

GROUND LEVEL

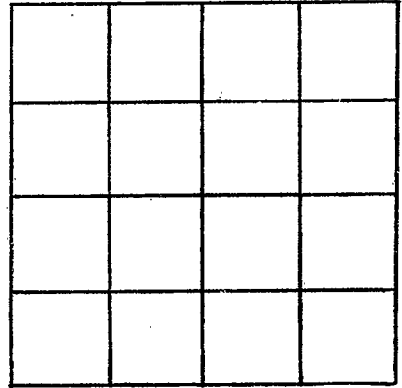

SECTION _____

Please indicate well location X.

ADDITIONAL INFORMATION

If more than one screen,
show locations of each on sketch.