

STONE  
L8  
6-9-71

MISSISSIPPI  
BOARD OF WATER COMMISSIONERS  
416 North State Street  
Jackson, Mississippi 39201

**CODED**

WATER WELL DRILLERS LOG

June 9 1971 Ladner's Well Works Stone  
date well completed firm name county well located

LANDOWNER: Thomas East  
McHenry, Miss.  
(mailing address)

description of formations encountered	from	to
yellow clay	0	110
Blue clay	110	190
Blue sand	190	230

WELL LOCATION:  
sec. 8 T. 4 N. R. 11 E  
2 miles E. of McHenry  
(distance) (direction) (nearest town)

WELL PURPOSE: Home  
(home, irrigation, municipal, industrial)

- WELL COMPLETION DATA:
- (1) diameter (inches) 2 inch
  - (2) total depth (feet) 240 ft.
  - (3) static water level (feet) 110 <sup>below</sup> above top of ground.
  - (4) casing Galv. 230 ft.  
(material) (depth)  
2 in. (size) If telescope see back.
  - (5) screen 10 ft., 230 ft.  
(length) (depth to top)  
2 in., SS.  
(size) (material)
  - (6) pump 2 5 gal.  
(HP) (yield gpm)  
Elec.  
(type power)
  - (7) electric log no.  
(yes or no)
- (organization running log)
- (8) how well bottom plugged  
Ball check

**CODED**


JUN 21 1971

MISS. BD. OF  
WATER COMMISSIONERS

DRILLERS REMARKS:

If well telescopes please sketch and show depths.

GROUND LEVEL

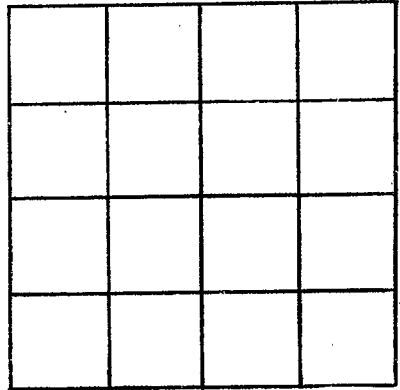

SECTION \_\_\_\_\_

Please indicate well location X.

ADDITIONAL INFORMATION

If more than one screen, show locations of each on sketch.