

**STONED**  
**CODED**  
 L11  
 9-9-71

MISSISSIPPI  
 BOARD OF WATER COMMISSIONERS  
 416 North State Street  
 Jackson, Mississippi 39201

WATER WELL DRILLERS LOG

9-9 date well completed 71 Parnell Anderson firm name Stone county well located

LANDOWNER: Colon McMurphy  
Perkinston

description of formations encountered	from	to
TOP SOIL	0	3
Red Sandy Clay	3	14
Red clay	14	28
Sand with clay st	28	64
Coars Sand	64	75

(mailing address)  
 WELL LOCATION:  
 sec. 23 T 4 S R. 11 W  
5 miles S-E of Perkinston  
 (distance) (direction) (nearest town)

WELL PURPOSE: Home  
 (home, irrigation, municipal, industrial)

WELL COMPLETION DATA:  
 (1) diameter (inches) 8  
 (2) total depth (feet) 80  
 (3) static water level (feet) 38 below top of ground.  
 (4) casing Pvc, 75 (material), (depth)  
 (size) if telescope see back.  
 (5) screen 5, 75 (length), (depth to top)  
2, P.V.C. (size), (material)  
 (6) pump 1, 11 (HP), (yield gpm)  
Elect (type power)  
 (7) electric log (yes or no)  
 (organization running log)

(8) how well bottom plugged Backwash Valve


DRILLERS REMARKS:

MADE 9-9-1971

MISS. BD. OF  
 WATER COM.

If well telescopes please sketch and show depths.

GROUND LEVEL

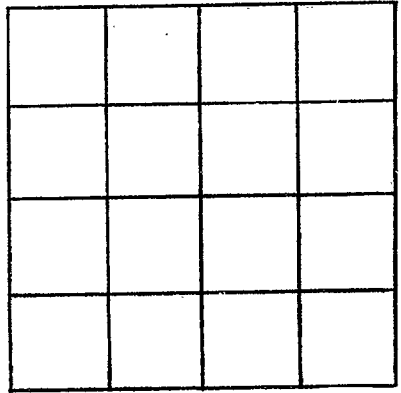

SECTION \_\_\_\_\_

Please indicate well location X.

ADDITIONAL INFORMATION

If more than one screen, show locations of each on sketch.