

MISSISSIPPI
BOARD OF WATER COMMISSIONERS
416 North State Street
Jackson, Mississippi 39201

CODED

WATER WELL DRILLERS LOG

STONE
L 12
11-9-72

11-9 date well completed 1972 Mc B Air King Co. firm name Stone county well located

LANDOWNER:
W LOX Television
Dubays Rd. Biloxi, Miss.
(mailing address)

description of formations encountered	from	to
Surface	0	12
Sand	12	35
Red clay	35	50
White clay	50	60
Blue clay	60	125
Sand	125	135
Blue clay	135	200
Sand	200	250
Blue clay	250	+

WELL LOCATION:
sec. 4 T. 4 S. R. 11 W.
3 miles E of McHenry
(distance) (direction) (nearest town)

WELL PURPOSE: Cooling Equipment
(home, irrigation, municipal, industrial)

WELL COMPLETION DATA:

(1) diameter (inches) 4"

(2) total depth (feet) 250 FT

(3) static water level (feet) 135 below top of ground.

(4) casing Galvanized Steel - 240
(material) (depth)
4" if telescope see back.
(size)

(5) screen 10 FT, 240
(length) (depth to top)
4", Stainless Steel / Schorger
(size) (material)

(6) pump 1 1/2, 15
(HP) (yield gpm)
200V 1Ø Submersible
(type power)

(7) electric log No
(yes or no)

(organization running log)

CODED


(8) how well bottom plugged
4" Back Wash Valve

DRILLERS REMARKS:

DEC 11 1972

If well telescopes please sketch and show depths.

GROUND LEVEL

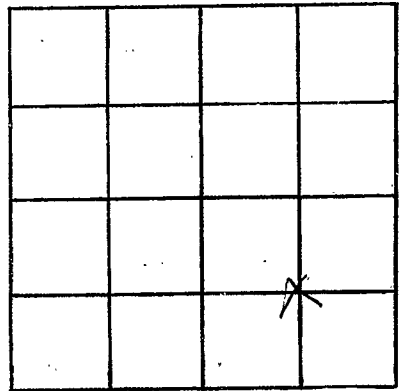

SECTION 4

Please indicate well location X.

ADDITIONAL INFORMATION

If more than one screen, show locations of each on sketch.