

MISSISSIPPI
BOARD OF WATER COMMISSIONERS
416 North State Street
Jackson, Mississippi 39201

CODED

WATER WELL DRILLERS LOG

4-28 1972 Parnell Anderson Stone
date well completed firm name county well located

LANDOWNER: Dan Orneal
McHenry Mrs
(mailing address)

WELL LOCATION:
sec. 9 T. 4 S. R. 11 E W.
4 miles E of McHenry
(distance) (direction) (nearest town)

WELL PURPOSE: Home
(home, irrigation, municipal, industrial)

- WELL COMPLETION DATA:
- (1) diameter (inches) 2
 - (2) total depth (feet) 230
 - (3) static water level (feet) 135 below top of ground.
 - (4) casing Plastic, 225
(material) (depth)
 - (size) if telescope see back.
 - (5) screen 5', 225
(length) (depth to top)
 - 2", Plastic
(size) (material)
 - (6) pump 1 4
(HP) (yield gpm)
 - Elect
(type power)
 - (7) electric log _____
(yes or no)
 - _____
(organization running log)
 - (8) how well bottom plugged Backwash Valve

description of formations encountered	from	to
Top Soil	0	2
Red Clay	2	20
Fine Sand	20	24
Blue Clay	24	168
Fine Sand	168	181
Blue Clay	181	206
Fine Sand	206	214
Coarse Sand	214	230


CODED

MAY 25 1973

DRILLERS REMARKS:

If well telescopes please sketch and show depths.

GROUND LEVEL

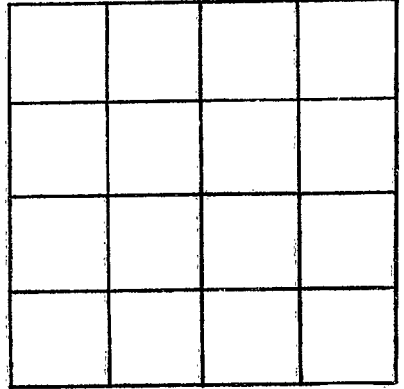

SECTION _____

Please indicate well location X.

ADDITIONAL INFORMATION

If more than one screen, show locations of each on sketch.