

STONE
L17
2-1-74

MISSISSIPPI
BOARD OF WATER COMMISSIONERS
416 North State Street
Jackson, Mississippi 39201
WATER WELL DRILLERS LOG

CODED

2-1-74 19 R. T. Moore STONE
date well completed firm name county well located

LANDOWNER: Jerry Somerville
General Del.

McHenry, MISS
(mailing address)

WELL LOCATION:
sec. 5 T 4 N R 11 E
2 miles E of McHenry
(distance) (direction) (nearest town)

WELL PURPOSE:
(home, irrigation, municipal, industrial)

WELL COMPLETION DATA:

- (1) diameter (inches) 4"
- (2) total depth (feet) 270'
- (3) static water level (feet) 160' ^{below} top of ground.
- (4) casing PVC, 260'
(material) (depth)
(size) If telescope see back.
- (5) screen 10' 260'
(length) (depth to top)
4" PVC
(size) (material)
- (6) pump 1 20
(HP) (yield gpm)
E
(type power)
- (7) electric log (yes or no)
- (organization running log)
- (8) how well bottom plugged
B W Moore

description of formations encountered	from	to
TOP SOIL	0	10
Gravel & Sand	10	16
white clay	16	160
white & Blue clay	160	160
FINE Sand	160	180
Blue clay	180	240
Coarse Gravel Sand	240	270

CODED


MAR 18 1974

DRILLERS REMARKS:

MISS. RD. OF WATER COMMISSIONERS

If well telescopes please sketch and show depths.

GROUND LEVEL

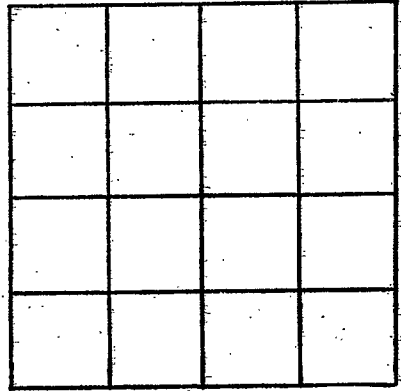

SECTION _____

Please indicate well location X.

ADDITIONAL INFORMATION

If more than one screen, show locations of each on sketch.