

STONE  
L 19  
10/21/74

MISSISSIPPI  
BOARD OF WATER COMMISSIONERS  
416 North State Street  
Jackson, Mississippi 39201

CODED

WATER WELL DRILLERS LOG

10-21-74 date well completed      1974 Parnell Anderson Stone firm name      Stone county well located

LANDOWNER:  
*Lyn Latt*  
  
(mailing address)

description of formations encountered	from	to
Top Soil	0	4
Red Clay	4	14
Fine Sand	14	61

WELL LOCATION:  
sec. 3 T. 4 S. R. 11 W.  
5 miles SE of Park  
(distance) (direction) (nearest town)

WELL PURPOSE: HOME  
(home, irrigation, municipal, industrial)

WELL COMPLETION DATA:

(1) diameter (inches) 2"

(2) total depth (feet) 61'

(3) static water level (feet) 22' below top of ground.

(4) casing Plastic, 5-6'  
(material) (depth)

\_\_\_\_\_ If telescope see back.  
(size)

(5) screen 5', 5-6'  
(length) (depth to top)

2", Plastic  
(size) (material)

(6) pump 1, 7  
(HP) (yield gpm)

Electric  
(type power)

(7) electric log no  
(yes or no)

\_\_\_\_\_ (organization running log)

(8) how well bottom plugged Plugged


CODED

NOV 12 1974

DRILLERS REMARKS:

If well telescopes please sketch and show depths.

GROUND LEVEL

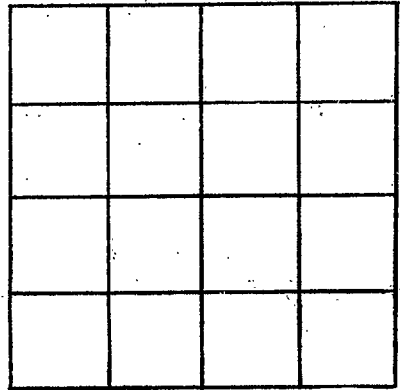

SECTION \_\_\_\_\_

Please indicate well location X.

ADDITIONAL INFORMATION

If more than one screen, show locations of each on sketch.