	<b>State Well Report</b>	For Office Use Only:
County: STONE	Part 1 – Driller's Log	For Onice Use Only:
	Mississippi Department of Environmental Quality	Aquifer:
Permit #:	Office of Land and Water Resources	Well #: L 45
Driller:	P.O. Box 10631	weii #
	Jackson, MS 39289-0631	L. S. Elevation:
Date drilling completed:	(601)961-5210	
	(601)354-6938 (fax)	E-log #:

۱

٩

State Law requires that this report be prepared by the license holder responsible for the work and filed with the Department at the above address within 30 days of completion of drilling of the well or borehole.					
Information on Well Owner	Well or Borehole Location				
(Landowner if borehole is not for a water well)					
	Latitude: <u>30° 42</u> ;[8,5" Longitude: <u>89° 2 ,59</u> "				
Owner Name Magnolia Development + Holdings, LLC Mailing Address: 1145 East Matterry Rd	Method of Lat/Long (circle one): Conventional Survey,				
Mailing Address: 1195 East Mc. Henry Ka	USGS quad, Hand-held GPS, Survey-grade GPS				
	NW14 NW14 Sec 13 Twn 45 Rng 11W				
McHenry MS 39561 City State Zip Code	Distance Direction Nearest Town				
Telephone No. (850) 259 - 5502	Distance Direction Nearest Town <u>13.5</u> Miles <u>SE</u> of <u>Wiggins</u>				
Well / Borel	hole Data				
Date drilling started: $2 - 10 - 14$ Date drilling completed: $2 - 13 - 14$ Hole depth: $159^{1}$ Hole diameter: $6.5^{"}$					
Location of the source of any surface water used for drilling:					
Logs run (circle all applicable): No log run Electric Gamma Ray Density Sonic Neutron Other:					
Purpose of borehole (check one): Water Well Geotechnical/Geological Investigation Ground Source Heat Pump					
Seismic SurveyOther ( <i>describe</i> ) If drilling is not related to water well construction, skip the remainder of this block					
Purpose of Well (check one): Home 🖌 Industrial Public Supply Irrigation Fish Culture Other:					
If a flowing well, method of flow regulation: Valve Other (describe)					
Static Water Level: 89 feet above or below (circle one) land surface Date measured: 2-12-14					
Method of Measurement (circle one) steel tape electric tape air line other:					
Well depth: 160' Well grouted to a depth of 10 feet Type of grout (circle one): Weat Cement Bentonite Mix					
Casing length: $\underline{140'}$ feet Casing diameter: $\underline{4}$ inches Type of casing: $\underline{PVC}$					
Screen length: $20$ feet Screen diameter: $4$ inches Type of screen: $PVC$					
Screen slot size: <u>1008</u> inches Setting depth: From <u>140</u> feet to <u>160</u> feet					
Type of completion (circle all applicable): Gravel packed Underreamed Telescoped Open hole Natural Development					
Other (describe):					
Top of lap pipe or reduction in casing: feet. If telescoped or more than one screen, describe on next page					
	FormAEGEIVED				

APR 02 2014

BY: OLWR

45

Description of formations encountered must be provided for all


wells and boreholes, unless specifically exempted by regulations

## The sketch below only required for water wells

If well telescopes, show depths on sketch. Ground Level.

on skeich.	Description of Formations Encountered	From (depth)	To (depth)
	Ltbr yellow Cl Ltbr sdcl Ltbrclsd	Ground Level	4014
	1thr sdci	40	75'
	Lthreisd	75'	120'
	Ltbrsd	120'	160
			<u> </u>
		-	1
			-
			<u> </u>
			L

If more than one screen, show location of each on sketch

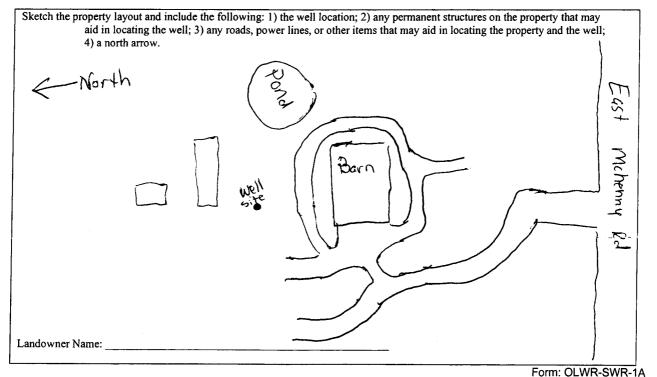

I certify that the well/borehole was drilled, constructed, and completed in accordance with all applicable requirements of the Mississippi Department of Environmental Quality and the Mississippi Department of Health, regulations, if applicable, and state

Date

eath S. Williams 0-790 3-25-14

RECEIVED

Print Name of Responsible Licensee and License No.

Signature of Licensee

APR 0 2 2014



STATE WELL REPORT					
	Part 2 Installer's Completion Report				
Office	Department of Environmental Quality Aquifer:				
Driller: J	P.O. Box 10631 Jackson, MS 39289-0631 Well #: <u>145</u>				
Date completed:	(601)961-5210 (601)354-6938 (fax) Elevation:				
<u>Copy information from block on Part 1</u>	ater well contractor or a licensed pump installer. A copy of Part 1 of the				
report must be attached and both parts filed with the Dep	artment at the above address within 30 days of well completion.				
Well Owner Information Owner Name: <u>Magnolia</u> <u>Development</u> Holdings, LLC Mailing Address: <u>1145 East McHenry</u> Rd	Well Location Latitude: <u>30°42' 18.5</u> "Longitude: <u>89°2'54</u> "				
Mailing Address: 1143 E4St McHenry Rd					
	USGS quad, Hand-held GPS V, Survey-grade GPS				
McHenry MS 3950 City State Zip Code	$\frac{61}{e} \frac{NW_{4}NW_{4} \operatorname{sec} 13 \operatorname{T} 4S \operatorname{R} 11W}{11}$				
era ari rraa	Distance Direction Nearest Town				
Telephone No. (850) 254-5502	<u>lais</u> Miles <u>SE</u> of <u>Wiggins</u>				
Ритр Туре	Power Type				
Circle one	Circle one				
Air Lift Jet Submersible	Diesel Engine Gasoline Engine Natural Gas				
Bucket Piston Turbine	Electric Motor Hand Tractor PTO				
Centrifugal Rotary Flowing Well					
Other (specify):	Horse Power Rating of Motor:				
Date Pump Installed: 2 - 13 - 14	Setting Depth: 120 feet				
Rated Pump Capacity: Gallons Per Mir	nute Number of Stages: 10				
Pump Test Data	Method of Measuring Water Level				
Date Well Tested: $2 - (3 - (4))$	Circle one				
Static Water Level (A): Feet Below Land Sur	Air Line Electric Measuring Line Steel Tape				
Pumping Water Level (B):Feet Below Land Surf	Other (specify):				
Drawdown [(B) – (A)]:Feet Below Land Sur	face For flowing well, measured shut in head:feet				
Fest Pumping Rate: 23 Gallons Per Min	nute Well yielded GPM with a drawdown of				
Duration of Pump Test (minimum 4 hours):	pursfeet afterhours of pumping				
	habert of many later All and				
HEREBY CERTIFY that the above statements are true to t Heath S. Williams 0-790	RECEIVE				
Print Name of Pump Installer and License No. (if applicable)					
	Form: OLWR:SWR:12				

٠

**t** 

BY:	OL	WR