

STONE
L 2000
3-2-76

MISSISSIPPI
BOARD OF WATER COMMISSIONERS
416 North State Street
Jackson, Mississippi 39201

WATER WELL DRILLERS LOG

3-2
date well completed

1976 Perme Anderson
firm name

Stone
county well located

LANDOWNER:
Gerald Bond
(mailing address)

description of formations encountered	from	to
Top Soil	0	3
Fine Sand	3	28
White Clay	28	45
Coarse Sand	45	60

WELL LOCATION:
sec. 4 T. 4 S. R. 11 E. W. 9
9 miles S of Wagon
(distance) (direction) (nearest town)

WELL PURPOSE: HOME
(home, irrigation, municipal, industrial)

WELL COMPLETION DATA:

(1) diameter (inches) 2"

(2) total depth (feet) 60'

(3) static water level (feet) 81' below top of ground.

(4) casing Plastic 55'
(material) (depth)

(size) If telescope see back.

(5) screen 5" (length) 55' (depth to top)
2" Plastic
(size) (material)

(6) pump 1 (HP) 11 (yield, gpm)
E-Cut
(type power)

(7) electric log no
(yes or no)

(organization running log)

(8) how well bottom plugged
Capped


DRILLERS REMARKS:

DEPT. OF WATER CONTROL
APR 5 1976

MISS. BD. OF WATER COMMISSIONERS

If well telescopes please sketch and show depths.

GROUND LEVEL

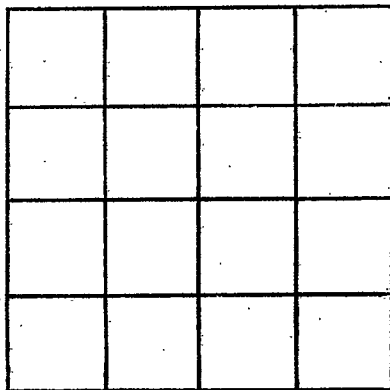

SECTION _____

Please indicate well location X.

ADDITIONAL INFORMATION

If more than one screen,
show locations of each on sketch.