

Need address & nearest town.

STONE
L 2001
5-4-76

MISSISSIPPI
BOARD OF WATER COMMISSIONERS
416 North State Street
136 Jackson, Mississippi 39201

WATER WELL DRILLERS LOG

5-4-76 date well completed 1976 firm name Stone county well located

LANDOWNER: Oscar Redman
(mailing address)

WELL LOCATION: sec 2 T 4 S R 11 E W
(distance) miles (direction) of (nearest town)

WELL PURPOSE: HOME
(home, irrigation, municipal, industrial)


WELL COMPLETION DATA:
(1) diameter (inches) 2"
(2) total depth (feet) 140'
(3) static water level (feet) 102' below above top of ground.
(4) casing Plastic 135" (material) (depth)
(size) if telescope see back.
(5) screen 5' 135" (length) (depth to top)
2" Plastic (size) (material)
(6) pump 1/2 (HP) 60 (yield gpm).
Electric (type power)
(7) electric log no (yes or no).
(organization running log)
(8) how well bottom plugged B with 1/2" pipe

description of formations encountered	from to	
	feet	feet
Top Soil	0	4
Sandy Clay	4	18
Blue Clay	18	138
Coarse Sand	138	140

DRILLERS REMARKS:

If well telescopes please sketch and show depths.

GROUND LEVEL

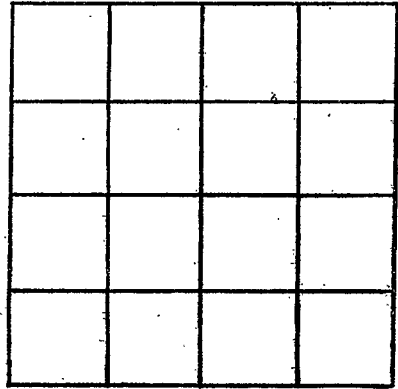

SECTION _____

Please indicate well location X.

ADDITIONAL INFORMATION

If more than one screen, show locations of each on sketch.