

Stone  
 L 2003  
 8/13/76

MISSISSIPPI  
 BOARD OF WATER COMMISSIONERS  
 416 North State Street  
 135 Jackson, Mississippi 39201

WATER WELL DRILLERS LOG

8-13 1976 Pearl Anderson Stone  
 date well completed firm name county well located


LANDOWNER:	description of formations encountered	from	to
<u>String Brooks</u> (mailing address)			
<u>WELL LOCATION:</u> sec. <u>9</u> T. <u>4</u> N. R. <u>11</u> S <u>5</u> miles <u>SE</u> of <u>Deak</u> (distance) (direction) (nearest town)	<u>Sandy Clay</u>	<u>4</u>	<u>12</u>
<u>WELL PURPOSE:</u> <u>HOME</u> (home, irrigation, municipal, industrial)	<u>Coarse Sand</u>	<u>12</u>	<u>32</u>
<u>WELL COMPLETION DATA:</u>			
(1) diameter (inches) <u>2"</u>			
(2) total depth (feet) <u>32'</u>			
(3) static water level (feet) <u>18'</u> below top of ground.			
(4) casing <u>Plastic 27'</u> (material) (depth)			
(size) If telescope see back.			
(5) screen <u>5'</u> <u>27'</u> (length) (depth to top)			
<u>2"</u> <u>Plastic</u> (size) (material)			
(6) pump <u>1</u> <u>7</u> (HP) (yield gpm)			
<u>Elect</u> (type power)			
(7) electric log <u>no</u> (yes or no)			
(organization running log)			
(8) how well bottom plugged <u>Capped</u>			
DRILLERS REMARKS:			

RECEIVED  
 SEP 7 1976

MISS. Bd. OF WATER COMMISSIONERS

If well telescopes please sketch and show depths.

GROUND LEVEL

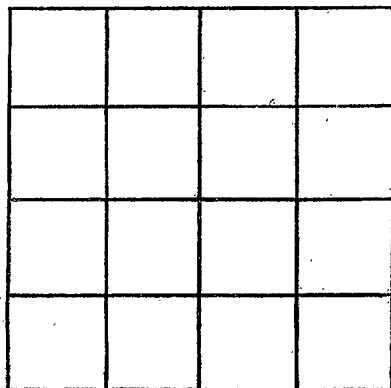

SECTION \_\_\_\_\_

Please indicate well location X.

ADDITIONAL INFORMATION

If more than one screen,  
show locations of each on sketch.