

Stone
L 2004
12/31/76

MISSISSIPPI
BOARD OF WATER COMMISSIONERS
416 North State Street
138 Jackson, Mississippi 39201

WATER WELL DRILLERS LOG

12/31 1976 Parnell Anderson Stone
date well completed 12/31/76 firm name county well located

LANDOWNER:	description of formations encountered	from	to
C. H. Whitney	Top Soil	0	2
(mailing address)	Red Clay	2	22
WELL LOCATION:	Course Sand	22	77
sec. 6 T. 40 S. R. 11 W.	Clay	77	88
20 miles S of Wiggins	Course Sand	88	99
(distance) (direction) (nearest town)			

WELL PURPOSE: HOME
(home, irrigation, municipal, industrial)

WELL COMPLETION DATA:

(1) diameter (inches) 2"

(2) total depth (feet) 99'

(3) static water level (feet) 49' below top of ground.

(4) casing Plastic, 94' (material) (depth)

(size) If telescope see back.

(5) screen 5' 94' (length) (depth to top)

2" Plastic (size) (material)

(6) pump 1 HP 11 (yield gpm)

Elect (type power)

(7) electric log no (yes or no)

(organization running log)


(8) how well bottom plugged Capped

DRILLERS REMARKS:

RECEIVED
JAN 5 1977
MISS. BD. OF WATER COMMISSIONERS

If well telescopes please sketch and show depths.

GROUND LEVEL

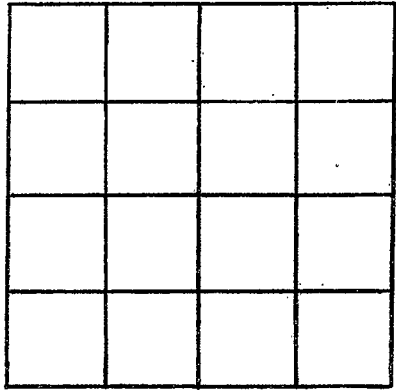

SECTION _____

Please indicate well location X.

ADDITIONAL INFORMATION

If more than one screen, show locations of each on sketch.