

STONE
 L 2005
 4-8-77

MISSISSIPPI
 BOARD OF WATER COMMISSIONERS
 416 North State Street
 Jackson, Mississippi 39201

WATER WELL DRILLERS LOG

4-8 1977 *Pennell Petroleum Stone*
 date well completed firm name county well located

LANDOWNER:	description of formations encountered	from	to
<i>Buddy Buland</i>	<i>Top Soil</i>	0	2
(mailing address)	<i>Course Sand</i>	2	45
WELL LOCATION:			
sec. <i>9</i> T <i>4</i> N R. <i>11</i> E <i>6</i> miles S E of <i>Park</i> (distance) (direction) (nearest town)			
WELL PURPOSE: <i>HOME</i> (home, irrigation, municipal, industrial)			
WELL COMPLETION DATA:			
(1) diameter (inches) <i>2"</i>			
(2) total depth (feet) <i>45</i>			
(3) static water level (feet) <i>31'</i> below top of ground.			
(4) casing <i>Plastic</i> <i>40'</i> (material) (depth)			
_____ If telescope see back. (size)			
(5) screen <i>5'</i> <i>40'</i> (length) (depth to top)			
<i>2"</i> <i>Plastic</i> (size) (material)			
(6) pump <i>1/2</i> <i>6</i> (HP) (yield gpm)			
<i>Cast</i> (type power)			
(7) electric log <i>no</i> (yes or no)			
_____ (organization running log)			
(8) how well bottom plugged <i>Capped</i>			
DRILLERS REMARKS:			


RECEIVED

MAY 9 1977

MISS. BD. OF WATER COMMISSIONERS

If well telescopes please sketch and show depths.

GROUND LEVEL

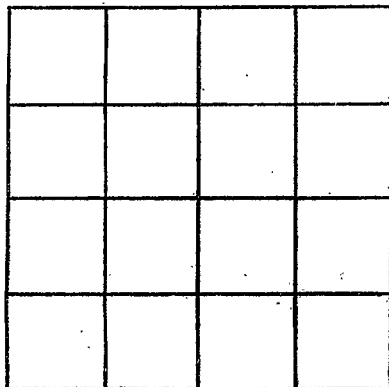

SECTION _____

Please indicate well location X.

ADDITIONAL INFORMATION

If more than one screen, show locations of each on sketch.