

Stone  
L 2000  
11/17/77

MISSISSIPPI  
BOARD OF WATER COMMISSIONERS  
416 North State Street  
Jackson, Mississippi 39201

WATER WELL DRILLERS LOG

11-17 1977 Harrell Anderson Stone  
date well completed firm name county well located

LANDOWNER:  
Dan ONeal  
  
(mailing address)

WELL LOCATION:  
sec. 9 T. 4 N. R. 11 E.  
S. W.  
2 1/2 miles E of M'Penny  
(distance) (direction) (nearest town)

WELL PURPOSE: HOME  
(home, irrigation, municipal, industrial)

- WELL COMPLETION DATA:
- (1) diameter (inches) 4"
  - (2) total depth (feet) 272'
  - (3) static water level (feet) 105' below top of ground.
  - (4) casing Plastic, 262'  
(material) (depth)  
    (size) if telescope see back.
  - (5) screen 10", 262'  
(length) (depth to top)  
    4", Plastic  
(size) (material)
  - (6) pump 1 12  
(HP) (yield gpm)  
Elect  
(type power)
  - (7) electric log NO  
(yes or no)  
  
(organization running log)
  - (8) how well bottom plugged Back wash valve

description of formations encountered	from to	
<u>Top Soil</u>	<u>8</u>	<u>2</u>
<u>Fine Sand</u>	<u>2</u>	<u>18</u>
<u>Blue Clay</u>	<u>18</u>	<u>235'</u>
<u>Fine Sand</u>	<u>235</u>	<u>260</u>
<u>Coarse Sand</u>	<u>260</u>	<u>272</u>


DRILLERS REMARKS:

RECEIVED  
DEC 6 1977

MISS. BD. OF WATER COMMISSIONERS

If well telescopes please sketch and show depths.

GROUND LEVEL

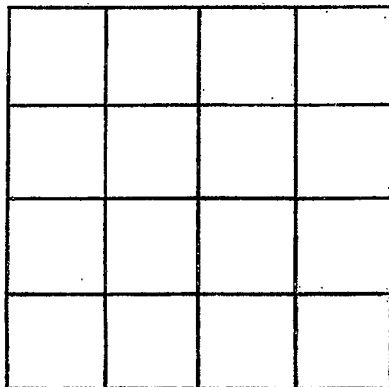

SECTION \_\_\_\_\_

Please indicate well location X.

ADDITIONAL INFORMATION

If more than one screen, show locations of each on sketch.