

STONE  
L 2007  
10-20-78

MISSISSIPPI  
BOARD OF WATER COMMISSIONERS  
416 North State Street  
Jackson, Mississippi 39201

WATER WELL DRILLERS LOG


10-20 1978 Pamell Anderson Stone  
date well completed firm name county well located

LANDOWNER:	description of formations encountered	from	to
<u>Ronnie Moran</u>			
(mailing address)	<u>Sandy clay</u>	<u>1</u>	<u>16</u>
WELL LOCATION:	<u>Blue clay</u>	<u>16</u>	<u>184</u>
sec. <u>11</u> T. <u>4</u> R. <u>11</u>	<u>Medium Sand</u>	<u>184</u>	<u>210</u>
<u>6</u> miles <u>SE</u> of <u>Perk</u>			
(distance) (direction) (nearest town)			
WELL PURPOSE: <u>HOME</u>			
(home, irrigation, municipal, industrial)			
WELL COMPLETION DATA:			
(1) diameter (inches) <u>2"</u>			
(2) total depth (feet) <u>210'</u>			
(3) static water level (feet) <u>125'</u> below top of ground.			
(4) casing <u>Plastic 205'</u>			
(material) (depth)			
(size) if telescope see back.			
(5) screen <u>5'</u> <u>205'</u>			
(length) (depth to tcp)			
<u>2"</u> <u>Plastic</u>			
(size) (material)			
(6) pump <u>1 1/2</u> <u>6</u>			
(HP) (yield gpm)			
<u>Elect</u>			
(type power)			
(7) electric log <u>no</u>			
(yes or no)			
(organization running log)			
(8) how well bottom plugged <u>Capped</u>			
DRILLERS REMARKS:			

RECEIVED  
NOV - 1 1978  
MISS. Bd. OF WATER COM.

If well telescopes please  
sketch and show depths.

GROUND LEVEL

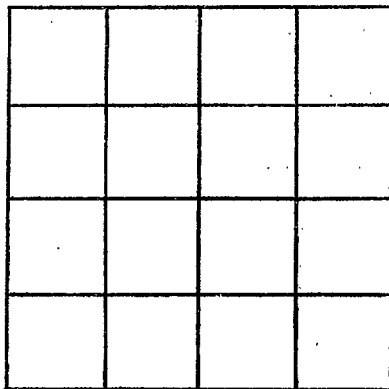

SECTION \_\_\_\_\_

Please indicate well location X.

ADDITIONAL INFORMATION

If more than one screen,  
show locations of each on sketch.