

STONE

L 2008

8-26-78

MISSISSIPPI  
 BOARD OF WATER COMMISSIONERS  
 416 North State Street  
 Jackson, Mississippi 39201

WATER WELL DRILLERS LOG

Aug 26 1978  
date well completed

Thurston Well Drilling Stone  
firm name

Stone  
county well located

LANDOWNER: Walter Ray Hamman

description of formations encountered

from to

Rt. 3 Box 136

Perkingston Ms.  
(mailing address)

Red Clay	0	40
White Clay	40	165
Blue Clay	165	230
Fine Sand	230	250
Coarse Sand	250	273

WELL LOCATION:

sec. 16 T. 4 N. R. 11 E.  
4 miles E of McNenny  
(distance) (direction) (nearest town)

WELL PURPOSE: Home  
(home, irrigation, municipal, industrial)

WELL COMPLETION DATA:

- (1) diameter (inches) 2"
- (2) total depth (feet) 273
- (3) static water level (feet) 93' below top of ground.
- (4) casing pvc, 263 (material) (depth)  
if telescope see back.
- (5) screen 10, 263 (length) (depth to top)  
2" pvc (size) (material)
- (6) pump 1, 3 (HP) (yield gpm)  
electric (type power)

(7) electric log (yes or no)

(organization running log)

(8) how well bottom plugged Sand  
Shack

DRILLERS REMARKS:


RECEIVED

JAN 10 1979

MISS. BD. OF WATER COM

If well telescopes please sketch and show depths.

GROUND LEVEL

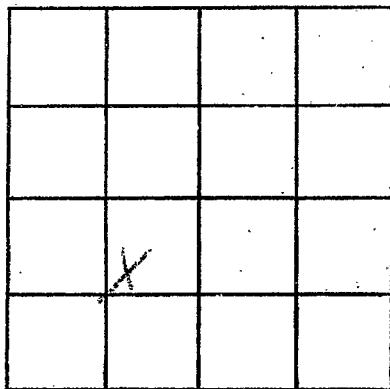

SECTION 11

Please indicate well location X.

ADDITIONAL INFORMATION

If more than one screen, show locations of each on sketch.