

STONE
L <u>2009</u>
7-06-78

**MISSISSIPPI
BOARD OF WATER COMMISSIONERS**
416 North State Street
Jackson, Mississippi 39201

WATER WELL DRILLERS LOG

July 6 1978 Duncan Well Drilling Stone
 date well completed firm name county well located

LANDOWNER: William J. Walker
Rte 3 Box 135
Perkinston, Mo.
 (mailing address)

description of formations encountered	from	to
Red Clay	0	40
White Clay	40	165
Blue Clay	165	230
fine sand	230	252
Coarse Sand	252	275


WELL LOCATION:
 sec. 16 T. 4 N. R. 11 E
4 miles E of McHenry
 (distance) (direction) (nearest town)

WELL PURPOSE: Home
 (home, irrigation, municipal, industrial)

- WELL COMPLETION DATA:
- diameter (inches) 2"
 - total depth (feet) 275
 - static water level (feet) 95 below above top of ground.
 - casing PVC, 265,
 (material) (depth)
 if telescope see back.
 (size)
 - screen 10', 265'
 (length) (depth to top)
2", PVC
 (size) (material)
 - pump
 (HP) (yield gpm)

 (type power)
 - electric log
 (yes or no)

 (organization running log)
 - how well bottom plugged Sand
Shark

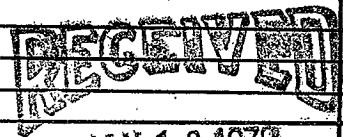


DRILLERS REMARKS:
Owner installed
his own pump

MISS. BD. OF WATER COMMISSIONERS

If well telescopes please sketch and show depths.

GROUND LEVEL

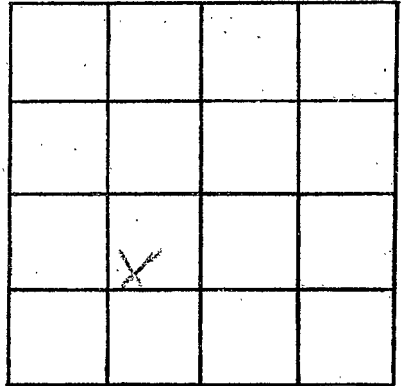

SECTION 16

Please indicate well location X.

ADDITIONAL INFORMATION

If more than one screen, show locations of each on sketch.