

Stone
L 2010
3/19/79
3-19

MISSISSIPPI
BOARD OF WATER COMMISSIONERS
416 North State Street
Jackson, Mississippi 39201

WATER WELL DRILLERS LOG

date well completed

firm name

county well located

1979 *Parnell Anderson* *Stone*

LANDOWNER:	description of formations encountered	from	to
<i>Boyer B Ireland</i>			
(mailing address)	<i>Red clay</i>	<i>3</i>	<i>18</i>
WELL LOCATION:	<i>Sandy clay</i>	<i>18</i>	<i>40</i>
sec. <i>S</i> T. <i>4</i> N. <i>R 11</i> E. <i>W</i>	<i>Coarse sand</i>	<i>40</i>	<i>78</i>
<i>3 1/2</i> miles <i>SE</i> of <i>Perk</i>			
(distance) (direction) (nearest town)			
WELL PURPOSE: <i>HOME</i>			
(home, irrigation, municipal, industrial)			
WELL COMPLETION DATA:			
(1) diameter (inches) <i>2"</i>			
(2) total depth (feet) <i>78'</i>			
(3) static water level (feet) <i>44'</i> below top of ground.			
(4) casing <i>Plastic 23'</i>			
(material) (depth)			
(size) if telescope see back.			
(5) screen <i>5" 73'</i>			
(length) (depth to top)			
<i>2" Plastic</i>			
(size) (material)			
(6) pump <i>1 9</i>			
(HP) (yield gpm)			
<i>Elect</i>			
(type power)			
(7) electric log <i>NO</i>			
(yes or no)			
(organization running log)			
(8) how well bottom plugged <i>Cap</i>			
DRILLERS REMARKS:			


Miss. Board of Water Comm.

APR 2 - 1979

RECEIVED

If well telescopes please sketch and show depths.

GROUND LEVEL

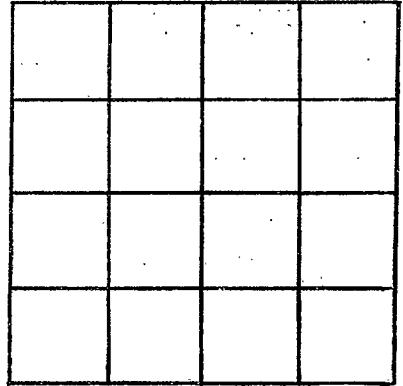

SECTION _____

Please indicate well location X.

ADDITIONAL INFORMATION

If more than one screen, show locations of each on sketch.