

STONE
L 20W
2-8-79

MISSISSIPPI
BOARD OF WATER COMMISSIONERS
416 North State Street
Jackson, Mississippi 39201

WATER WELL DRILLERS LOG

Feb. 8 1979 *Sumac Well Drilling* Stone
date well completed firm name county well located

LANDOWNER: <i>Rick Booker</i>	description of formations encountered	from	to
<i>Mc Henry Ms.</i> (mailing address)	<i>Sand & Gravel</i> <i>Blue Clay</i> <i>Fine Sand</i> <i>COARSE SAND</i>	0 72 180 210	72 180 210 240
WELL LOCATION: sec. <u>3</u> T. <u>4</u> R. <u>11</u> <u>5</u> miles <u>NE</u> of <u>McHenry</u> (distance) (direction) (nearest town)			
WELL PURPOSE: <i>Home</i> (home, irrigation, municipal, industrial)			
WELL COMPLETION DATA: (1) diameter (inches) <u>4"</u> (2) total depth (feet) <u>240</u> (3) static water level (feet) <u>190'</u> <small>(below above top of ground.)</small> (4) casing <u>PVC</u> , <u>230</u> , <small>(material) (depth)</small> <u> </u> if telescope see back. <small>(size)</small> (5) screen <u>10'</u> , <u>230</u> <small>(length) (depth to top)</small> <u>4"</u> , <u>PVC</u> <small>(size) (material)</small> (6) pump <u>1/2</u> <u>13</u> <small>(HP) (yield gpm)</small> <u>electric</u> <small>(type power)</small> (7) electric log <u> </u> <small>(yes or no)</small> <u> </u> <small>(organization running log)</small>			
(8) how well bottom plugged <u>Sand</u> <u>Shark</u>			
DRILLERS REMARKS:			


Miss. Board of Water Comm.

JUN 5 1979

RECEIVED

If well telescopes please sketch and show depths.

GROUND LEVEL

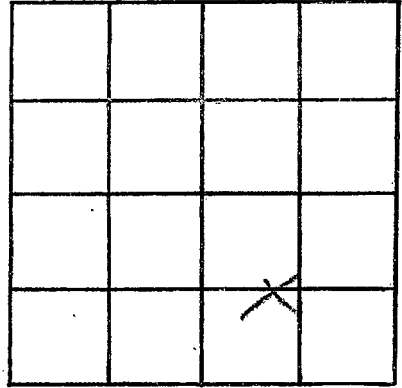

SECTION 3

Please indicate well location X.

ADDITIONAL INFORMATION

If more than one screen,
show locations of each on sketch.