

STONE
L 2012
5-29-79

MISSISSIPPI
 BOARD OF WATER COMMISSIONERS
 416 North State Street
 Jackson, Mississippi 39201

WATER WELL DRILLERS LOG

5-29 1979
 date well completed

Arnold Anderson
 firm name

Stone
 county well located

LANDOWNER:	description of formations encountered	from	to
<u>Alma Moran</u>	<u>Topsoil</u>	<u>0</u>	<u>7</u>
(mailing address)	<u>Clay</u>	<u>7</u>	<u>35</u>
WELL LOCATION:	<u>Course Sand</u>	<u>35</u>	<u>61</u>
sec. <u>10</u> T. <u>4</u> S. R. <u>11</u> E. W.			
<u>3 1/2</u> miles <u>E</u> of <u>W. H. Smith</u>			
(distance) (direction) (nearest town)			
WELL PURPOSE: <u>HOME</u> (home, irrigation, municipal, industrial)			
WELL COMPLETION DATA:			
(1) diameter (inches) <u>2"</u>			
(2) total depth (feet) <u>61</u>			
(3) static water level (feet) <u>18</u> below top of ground.			
(4) casing <u>Plastic</u> , <u>15-6'</u> (material) (depth)			
(size) if telescope see back.			
(5) screen <u>3"</u> , <u>5-6'</u> (length) (depth to top)			
<u>2"</u> , <u>Plastic</u> (size) (material)			
(6) pump <u>1/2</u> <u>7</u> (HP) (yield gpm)			
<u>C. Best</u> (type power)			
(7) electric log <u>no</u> (yes or no)			
(organization running log)			
(8) how well bottom plugged <u>Capped</u>			

DRILLERS REMARKS:


Miss. Board of Water Comm.

JUN - 8 1979

RECEIVED

If well telescopes please
sketch and show depths.

GROUND LEVEL

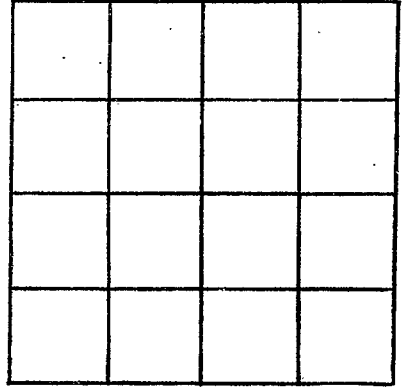

SECTION _____

Please indicate well location X.

ADDITIONAL INFORMATION

If more than one screen,
show locations of each on sketch.