

Stone
L 2013
6-4-79

MISSISSIPPI
BOARD OF WATER COMMISSIONERS
416 North State Street
Jackson, Mississippi 39201

WATER WELL DRILLERS LOG

6-4 1979 Parnell Anderson Stone
date well completed firm name county well located

LANDOWNER: Alma Moran
description of formations encountered from to
Top Soil 0 2
Clay 2 12
(mailing address)

WELL LOCATION:
sec. 10 T. 4 S. R. 11 W.
4 miles E of Mr. Hennes
(distance) (direction) (nearest town)

WELL PURPOSE: HOME
(home, irrigation, municipal, industrial)

WELL COMPLETION DATA:
(1) diameter (inches) 2"
(2) total depth (feet) 60'
(3) static water level (feet) 27' below above top of ground.
(4) casing Plastic 55'
(material) (depth)
(size) if telescope see back.
(5) screen 5' 5-3"
(length) (depth to top)
2" Plastic
(size) (material)
(6) pump 1 12
(HP) (yield gpm)
Elect
(type power)
(7) electric log no
(yes or no)
(organization running log)
(8) how well bottom plugged
Plugged

Miss. Board of Water Comm.


JUL 11 1979

RECEIVED

DRILLERS REMARKS:

If well telescopes please sketch and show depths.

GROUND LEVEL

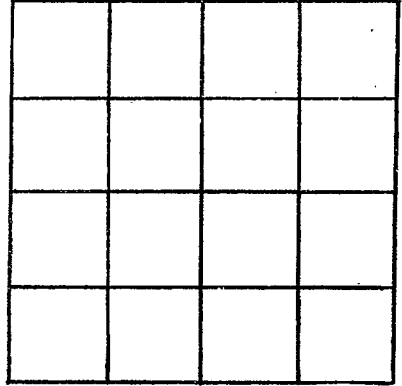

SECTION _____

Please indicate well location X.

ADDITIONAL INFORMATION

If more than one screen, show locations of each on sketch.