

Stone
L 2014
9-4-79

MISSISSIPPI
 BOARD OF WATER COMMISSIONERS
 416 North State Street
 Jackson, Mississippi 39201

AG
 H
 27

WATER WELL DRILLERS LOG

Sept. 4 1979 Tuncas Well Drilling Stone
 date well completed firm name county well located

LANDOWNER: Willie Beach
Rt. 3 Box 137
Perkinston, Ms.
 (mailing address)

description of formations encountered	from	to
<u>top sand</u>	<u>0</u>	<u>20</u>
<u>white clay</u>	<u>20</u>	<u>225</u>
<u>fine sand</u>	<u>225</u>	<u>250</u>
<u>course sand</u>	<u>250</u>	<u>280</u>

WELL LOCATION:
 sec 7 T 4 N R/L E
3 miles E of McHenry
 (distance) (direction) (nearest town)

WELL PURPOSE: Home
 (home, irrigation, municipal, industrial)

WELL COMPLETION DATA: 20" of 4"
 (1) diameter (inches) 4x2 20 of 2"
 (2) total depth (feet) 280'
 (3) static water level (feet) 110' below top of ground.
 (4) casing pvc, 270'
 (material) (depth)
 (size) If telescope see back.
 (5) screen 10', 270'
 (length) (depth to top)
2", pvc
 (size) (material)
 (6) pump 1/2 Sub., 10
 (HP) (yield gpm)
electric
 (type power)
 (7) electric log _____
 (yes or no)
 (organization running log)

(8) how well bottom plugged Sand
Shank


DRILLERS REMARKS:

DEPT. OF NATURAL RESOURCES
 BUREAU OF LAND & WATER RESOURCES

JAN 15 1980
 RECEIVED

If well telescopes please sketch and show depths.

GROUND LEVEL

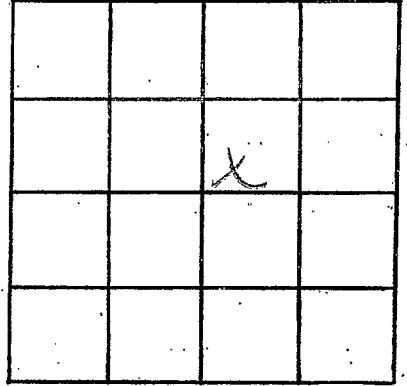

SECTION 2

Please indicate well location X.

ADDITIONAL INFORMATION

If more than one screen,
show locations of each on sketch.